

Planning & Building Agency
 Building Safety Division
 20 Civic Center Plaza
 P.O. Box 1988 (M-19)
 Santa Ana, CA 92702
 (714) 647-5800
 www.santa-ana.org

DISABLED ACCESS COMPLIANCE DOCUMENTATION FORM

ACC-01 CBC 2010

A. PURPOSE OF THIS DOCUMENTATION:

- Finding of unreasonable hardship for projects under \$132,536.28 (as of January 2011) per 2010 California Building Code (CBC) Section 1134B.2.1, Exception 1
- Full Compliance with the 2010 California Building Code

B. PROJECT INFORMATION TO BE COMPLETED BY PETITIONER:

Project Address: 1917 St. Andrews Place	Project Number: 10173636
Project Description: Voluntary Seismic Strengthening @ Roof	Total Construction Cost: \$ 23,750.00
Occupancy Classification/Use: B, S-1	Number of Stories: 1

- Business Name: Symbolic Displays, Inc.
- Legal Property Owner: Rob Soeci Phone No. 714-935-2314
- The cost of all construction contemplated in the determination of the valuation of improvement threshold based on the valuation of site and building improvements for the last three-year period (from ___/___/___ to ___/___/___). References:

Permit No.	Issuance Date	Valuation of Improvements
Total:		

- The minimum amount to be spent to provide disabled access under the subject building permit application (20% of Total Construction Cost / Project Valuation): \$23,750 x 1.50 = \$4,750

- Describe the impact of the proposed improvements on financial feasibility of the project:

- Describe the nature of accessibility that would be gained or lost with the proposed improvements:

Add (i) new HC parking space + signage
Replace a non-compliant drinking fountain w/ a new "accessible" fountain
Lower (e) paper towel dispensers to meet code.

7. Identify the accessibility features and equivalent facilities that **WILL** be brought into compliance with the latest edition of Title 24 as a part of this project and an estimate of the cost of each item: *(Documentation may be required)*

Accessible Features to be Made Accessible	Cost of Improvement
a. Entrance:	
<input type="checkbox"/> Ramp <input type="checkbox"/> Door <input type="checkbox"/> Landing <input type="checkbox"/> Stair/Steps	\$
b. Path of Travel:	
<input type="checkbox"/> Path of travel from building entrance to the area of remodel	\$
<input type="checkbox"/> Path of travel from the public way to the building entrance	\$
<input checked="" type="checkbox"/> Path of travel from accessible parking to the building entrance	\$ 2,800
<input type="checkbox"/> Path of travel to sanitary facilities / public phone / drinking fountain	\$
c. Sanitary facilities (Floor no.)	\$
d. Public phone(s)	\$
e. Drinking fountain(s)	\$ 1,600
f. Parking	\$
g. Signage	\$ 350
h. Alarms	\$
i. Other	\$
Total:	\$ 4,750

8. Identify the accessibility features that **WILL NOT** comply if a request for unreasonable hardship is granted. Provide an estimated cost of compliance for each item: *(Documentation may be required)*

Accessible Features Not to be Improved	Cost of Improvement
a.	\$
b.	\$
c.	\$
Total:	\$

9. **Petitioner must be the legal property owner or his/her legal representative:**

I certify that the above noted information is true and correct.

Legal Property Owner Architect/Engineer Contractor Other _____

Print Name: Michael Santillan Phone No. 714) 803-8454

Address: 27 Orchard, Lake Forest, CA 92630

Signature: Michael Santillan Date: 12/5/11

FOR AGENCY USE ONLY

Approved by: _____ Date: _____

ELKAY[®]

SPECIFICATIONS

Wall Mount Water Coolers Barrier-Free Access (Adult & Child) NSF/ANSI 61 Compliant Models EZ4, EZ8, EZS4, EZS8, EZSD and EZD

GENERAL

Self-contained, wall hung electric refrigerated water cooler. Chilling capacity of 50°F drinking water, based upon 80°F inlet water and 90°F ambient.

Models **EZS4** and **EZS8** have self-closing Easy-Touch Controls on front and both right and left sides.

Models **EZ4** and **EZ8** each have self-closing Easy-Touch Controls on the front only.

Model **EZSD** is non-refrigerated. Same as **EZS8** without cooling system. (Requires outlet for power cord.)

All models have a hooded stream projector with Easy-Touch Controls that require less than 3 pounds of force to activate. Valve with built-in flow regulator provide constant stream from 20 to 105 psi, water pressure. Bubbler orifice fully protected to meet all sanitary codes.

Non-pressurized stainless steel cooling tank is standard. Non-pressurized water tank is located after bubbler valve, so that tank is subject to line pressure only when Easy-Touch Control is pressed.

ADA COMPLIANT

These Water Coolers comply with the requirements of A.D.A. (Americans with Disabilities Act) when properly installed. Also meets the guidelines for children's environments providing the floor to orifice height is 30" or less and proper clear floor space is provided for parallel approach. (Based on Architectural and Transportation Barriers Compliance Board final ruling.) Check Local and State Codes.

NO LEAD DESIGN

These Water Coolers are certified to be lead-free as defined by the Safe Drinking Water Act. Elkay Water Coolers are manufactured with a waterway system utilizing copper components and completely lead-free materials. These waterways have no lead because all lead materials, such as leaded brass, have been removed. All joints are brazed using silver solder only. No lead solder is permitted. A strainer with an easily cleanable screen is provided to allow trapping and convenient removal of waterborne particulate of 140 microns and larger prior to their entry into the water cooler.

CAPACITIES CHART

Model Number	Base Rate	**GPH of 50°F Drinking Water			Rated Watts	Full Load Amps	Glass Filler Option	Ship. Wt. Lbs.
		Room Temperature °F						
		70°F	80°F	90°F				
EZS4	4.0	5.0	4.4	4.0	370	4.0	Yes	56
EZS8	8.0	9.7	8.8	8.0	370	4.0	Yes	56
EZ4	4.0	5.0	4.4	4.0	370	4.0	Yes	56
EZ8	8.0	9.7	8.8	8.0	370	4.0	Yes	56
EZSD	-	-	-	-	-	-	Yes	18
EZD	-	-	-	-	-	-	Yes	18


**Based on 80°F inlet water temperature. †Glass filler available at extra cost. Requires factory preparation to receive glass filler.

Rated watts shown are based on operational (run) time, in compliance with A.R.I. Standard 1010 conditions. Specific applications will determine the actual watts consumed per hour. Watts consumed will be based on number of people served per hour (usage), ambient temperatures, and inlet water temperature.


COOLING SYSTEM

Motor Compressor: Hermetically sealed, reciprocating type, 115V, 60 Hz single phase. Sealed-in lifetime oil supply. Equipped with electric cord and three prong molded rubber plug (domestic models).

Condenser: Fan cooled, copper tube with aluminum fins. Fan motor is permanently lubricated.

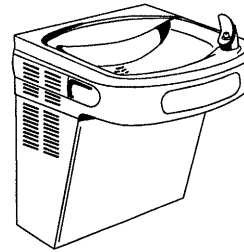

Model EZS

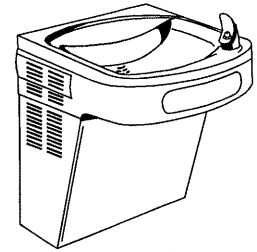

Model EZ

RATED FOR INDOOR APPLICATIONS ONLY

Cooling Unit: Combination tube-tank type. Self cleansing. Tube portion is continuous coil of copper tubing. Tank is stainless steel. Fully insulated with EPS foam which meets Underwriters Laboratories Inc. requirements for self-extinguishing material.

Refrigerant Control: Refrigerant HFC-134a is controlled by accurately calibrated capillary tube for positively trouble-free operation.

Temperature Control: Enclosed adjustable thermostat is factory pre-set. Requires no adjustment other than for altitude requirements. Easily accessible.

CONSTRUCTION

Frame: Galvanized structural steel chassis supports refrigeration system and fastens to wall. Provides increased structural integrity and rigidity to cooler.

Stainless Steel Basin: One piece polished to a uniform Elkay bright luster finish. Basin has integral drain grid, embossed bubbler pad. No exposed fasteners.

Exclusive Flexi-Guard® Safety Bubbler*: Innovative design utilizes an infused anti-microbial pliable polyester elastomer to prevent accidental mouth injuries. Flexes on impact, then returns to original position. Strong. Abrasion-resistant. Anti-sweat. Keyed in location to prevent rotation.

Upper Shroud: Contoured shock-absorbing, provides additional protection against accidental injury. No exposed fasteners.

Lower Shroud: One piece easy to remove and replace. Allows access to internal components from three sides.

Cabinet: Cabinet design allows for flush to wall mounting. No recess space is required.

Color Selection: Unless otherwise specified cabinet is two-tone gray on upper shroud with textured gray lower shroud. Stainless Steel lower shroud available at extra cost.

Protected by Elkay's 5 Year Limited Warranty on the refrigeration system of the unit.

Elkay Pressure-Type Water Coolers are designed to operate on 20 psi to 105 psi supply line pressure. If inlet pressure is above 105 psi, a pressure regulator must be installed in the supply line. Any damage caused by reason of connecting this product to supply line pressures lower than 20 psi or higher than 105 psi is not covered by the warranty.

STANDARDS



Elkay Electric Air Cooled Water Coolers are listed by Underwriters Laboratories Inc. and comply with both Canadian and U.S. requirements.

These units comply with A.R.I. Standard 1010.


This cooler is certified by WQA to lead-free compliance including NSF/ANSI 61-ANNEX G, AB 1953.

In keeping with our policy of continuing product improvement, Elkay reserves the right to change product specifications without notice. Please visit elkayusa.com for most current version of Elkay product specification sheets.


This specification describes an Elkay product with design, quality and functional benefits to the user. When making a comparison of other producers' offerings, be certain these features are not overlooked.

Wall Mount Water Coolers
Barrier-Free Access (Adult & Child)
NSF/ANSI 61 Compliant
Models EZ4, EZ8, EZS4, EZS8, EZSD and EZD

ELKAY®
ROUGH-IN DIMENSIONS

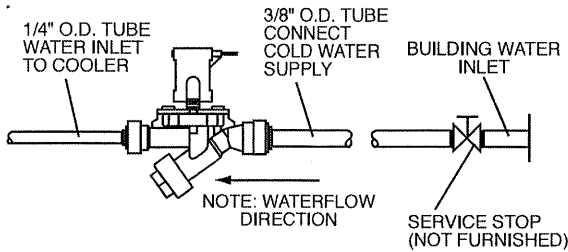

OPERATION OF QUICK CONNECT FITTINGS

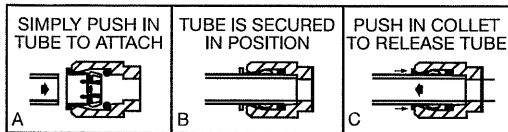

PUSHING TUBE IN BEFORE PULLING IT OUT HELPS TO RELEASE TUBE

Open space rough-in design permits new installation or replacement of existing fountains and coolers with this Elkay cooler when rough-in is within the outline shown. When the cooler is mounted as shown the location available is from 15" to 21-11/16" from floor and 1-1/16" to 7-1/4" from the left of centerline. Space is also available from 21-11/16" to 24-5/8" from floor and 2-3/4" to 7-1/4" from the left of centerline. Additional space is also available from 24-5/8" to 26-11/16" from floor and 3-3/4" to 7-1/4" from the left of centerline. Connections approaching the limits of these areas may be restricted and should only be considered for use until after an examination of the cooler has been made.

IMPORTANT!
INSTALLER PLEASE NOTE:

This water cooler has been designed and built to provide water to the user which has not been altered by materials in the cooler waterways.

The grounding of electrical equipment such as telephone, computers, etc., to water lines is a common procedure. This grounding may be in the building but may also occur away from the building. This grounding can cause electrical feedback into a water cooler creating an electrolysis which creates a metallic taste or causes an increase in the metal content of the water. This condition is avoidable by installing the cooler using the proper materials as shown below.

NOTICE


This water cooler must be connected to the water supply using a dielectric coupling. The cooler is furnished with a non-metallic strainer which meets this requirement.

The drain trap which is provided by the installer should also be plastic to completely isolate the cooler from the building plumbing system.

RATED FOR INDOOR APPLICATIONS ONLY

FRONT VIEW

SIDE VIEW

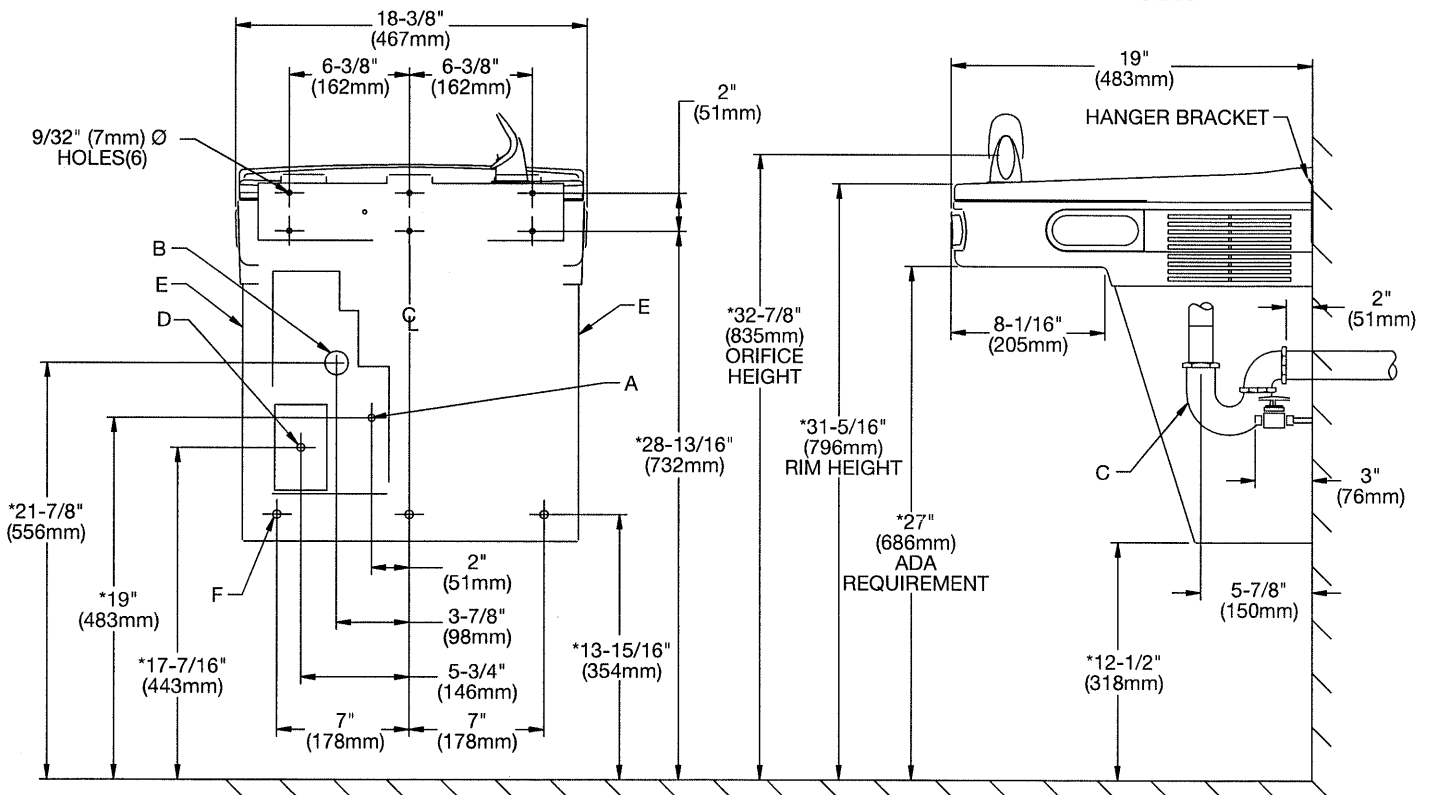

LEGEND

- A = RECOMMENDED WATER SUPPLY LOCATION. SHUT-OFF VALVE (NOT FURNISHED) TO ACCEPT 3/8 O.D. UNPLATED COPPER TUBE. 3" (76mm) MAXIMUM OUT FROM WALL.
 - B = RECOMMENDED LOCATION FOR WASTE OUTLET 1-1/4" O.D. DRAIN STUB 2 IN. (51mm) OUT FROM WALL.
 - C = 1-1/4" TRAP NOT FURNISHED.
 - D = ELECTRICAL SUPPLY (3) WIRE RECESSED BOX.
 - E = INSURE PROPER VENTILATION BY MAINTAINING 6" (152mm) (MIN.) CLEARANCE FROM CABINET LOUVERS TO WALL.
 - F = 7/16" BOLT HOLES FOR FASTENING UNIT TO WALL.
- *REDUCE HEIGHT BY 3 INCHES FOR INSTALLATION OF CHILDRENS ADA COOLER.

FEE CHECKLIST WORKSHEET

Received by: KH

SAPIN #: 10173636

FEE TYPE

REQUIRED

Yes No

Plan Check Fee	<input checked="" type="checkbox"/>	<input type="checkbox"/>
Disability Fee	<input type="checkbox"/>	<input checked="" type="checkbox"/>
SMIP Fee	<input checked="" type="checkbox"/>	<input type="checkbox"/>
Res. Dev. Fee	<input type="checkbox"/>	<input checked="" type="checkbox"/>
Fire Facility Fee	<input type="checkbox"/>	<input checked="" type="checkbox"/>
School Distr. Fee	<input type="checkbox"/>	<input checked="" type="checkbox"/>
Microfilm	<input type="checkbox"/>	<input checked="" type="checkbox"/>
FCWP Surcharge	<input type="checkbox"/>	<input checked="" type="checkbox"/>

CALCULATION AREA

COST/SQ FT X TOTAL SQ FT = VALUATION

per applicant

Counter computations/valuation \$ 23,000

Plan checker computation/final valuation \$ _____

CITY OF SANTA ANA

BUILDING PERMIT WORKSHEET

PLEASE PRINT

1/14/09:forms/Bldg.App.Worksheet

PROJECT ADDRESS: <u>1917 St. Andrew Place</u>		Bldg. SUITE: <u>F</u>		SAPIN # <u>10173636</u>	
USE OF BUILDING: RESIDENTIAL <input type="checkbox"/> <u>COMMERCIAL</u> <input checked="" type="checkbox"/> INDUSTRIAL <input type="checkbox"/> OTHER <input type="checkbox"/>				MASTER ID#	
NATURE OF WORK: NEW <input type="checkbox"/> ADD <input type="checkbox"/> <u>ALTER/T.I.</u> <input checked="" type="checkbox"/> DEMO <input type="checkbox"/> REROOF <input type="checkbox"/> REPAIR <input type="checkbox"/> SIGN <input type="checkbox"/> MISC <input type="checkbox"/>					
NEW/ADDITION/ALTERATION:					
1ST FL.. _____ SF		BASEMENT: YES/NO _____ SF		NO. OF STORIES: <u>1</u>	
2ND FL.. _____ SF		PATIO/ENCL. PATIO: _____ SF		BLDG. HEIGHT: _____	
TOTAL OF OTHER FLS: _____ SF		RES. REMODEL: _____ SF		PROPOSED USE: _____	
GARAGE/CARPORT: _____ SF		<u>ALTER/T.I.:</u> <u>23,250</u> SF			
JOB DESCRIPTION (non-residential projects see reverse side of this application): <u>Voluntary Seismic retrofit to a roof @ an existing 1-story bldg.</u>					
BUILDING OWNER'S NAME: <u>Rob Socci</u>				PHONE NO: <u>714)935-2314</u>	
ADDRESS: <u>3500 W. Orangewood Ave</u>		CITY: <u>Orange</u>		STATE: <u>CA</u>	ZIP: <u>92868</u>
TENANT'S NAME (Comm/Ind):				PHONE NO:	
CONTRACTOR'S NAME:		STATE CONTR. #:	LICENSE CLASS:	PHONE NO:	
ADDRESS:		CITY:	STATE:	ZIP:	
WORKERS COMP. POLICY#:	EXP. DATE:	INSURANCE COMPANY:	SANTA ANA BUS. LIC. #:		
ARCHITECT/ENGINEER: <u>Michael O'Brien</u>		STATE LICENSE #: <u>S-004468</u>	PHONE NO: <u>949)716-9990</u>		
ADDRESS: <u>27 Orchard</u>		CITY: <u>Lake Forest</u>	STATE: <u>CA</u>	ZIP: <u>92630</u>	
CONTACT NAME: <u>Michael Santillan</u>			PHONE NO: <u>714 803-8454</u>		
E-MAIL ADDRESS: <u>michael.santillan@nationaleng.com</u>			FAX NO: <u>949-716-9997</u>		

OFFICE USE ONLY: ACC OR SPC (CIRCLE ONE) _____ HRS PER _____ BLDG. FEE \$ _____

OCC. GROUP: _____ RECEIPT #: 58358 P/C FEE PD \$ 207.25

TYPE OF CONSTR: _____ VALUATION: \$ 23,000 SUBMITTAL DATE: 11/7

FIRE SPKR: YES / NO _____ A/C: YES / NO _____ FLOOD ZONE: _____ PROCESSED KH

RES. DEV. FEE: YES / NO _____ PRIOR DWELLING UNIT: YES / NO _____ COMMENTS: _____

PLANNING OK TO CHECK & DATE _____ BLDG. DEPT. APPROVAL & DATE _____

PLNG CONDITIONS: _____


PLEASE CHECK ALL THAT APPLY TO YOUR PROJECT

JOB DESCRIPTION CHECKLIST:

- | | |
|--|---|
| <input type="checkbox"/> Additional square footage | <input type="checkbox"/> Partition walls |
| <input type="checkbox"/> Awnings | <input type="checkbox"/> Rated corridors |
| <input type="checkbox"/> Canopy | <input type="checkbox"/> Rated shafts |
| <input type="checkbox"/> Ceiling work | <input type="checkbox"/> Roof mounted equipment |
| <input type="checkbox"/> Change of occupancy (use) | <input type="checkbox"/> Security bars |
| <input type="checkbox"/> Disabled accessible (H/C) restrooms | <input type="checkbox"/> Screening for equipment |
| <input type="checkbox"/> Dust collector | <input type="checkbox"/> Skylights |
| <input type="checkbox"/> Elevator shaft | <input type="checkbox"/> Stairs |
| <input type="checkbox"/> Exterior doors or windows | <input type="checkbox"/> Storefront/facade improvements |
| <input type="checkbox"/> Equipment pads | <input type="checkbox"/> Storage racks or shelving over 5'-9" |
| <input type="checkbox"/> Interior demo | <input type="checkbox"/> Walk-in coolers |
| <input type="checkbox"/> Kitchen equipment | |

ITEMS REQUIRING SEPARATE BUILDING PERMIT APPLICATIONS:

- Block wall
- Card readers
- Complete demo
- Fence
- Fire signaling system
- Fire sprinklers
- Flagpole
- Lawn sprinkler system
- Light Standards
- Parking lot repaving
- Parking lot restriping
- Pedestrian protection
- Pool/Spa
- Signs
- Spray booth
- Temporary power pole
- Trash enclosure

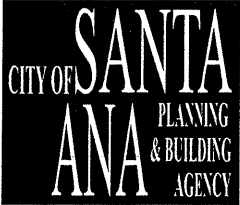

Planning & Building Agency
 Permits & Plan Check Section
 20 Civic Center Plaza
 P.O. Box 1988 (M-19)
 Santa Ana, CA 92702
 (714) 647-5800
 www.santa-ana.org

ACCELERATED PLAN CHECK REQUEST

HO18: 07-01-11

Project Address: 1917 E St Andrew

Misc. Receipt: 58391 Processed By: [Signature] Plan Checked By: _____

Cost: \$117.70 per hour for each discipline. The plan checker will estimate the number of hours for review. This fee is in addition to the regular plan check fee.

Type of Plan Check: Building 10173636 Electrical _____
 Est. Hrs. 2 Actual 2^{hrs} Est. Hrs. _____ Actual _____
 Plumbing _____ Mechanical _____
 Est. Hrs. _____ Actual _____ Est. Hrs. _____ Actual _____

Owner/Representative Signature: [Signature]

Print Name: Michael Santillan Date: 11/15/11

Telephone Number: (714) 803-8454 Fax Number: ()

MS An accelerated plan check review will not include the following:
Fire, Police, Public Works, Planning or Landscaping Plan Check

Revisions: If requesting an "accelerated revision", the cost will be \$207.25 per hour in addition to the accelerated fee of \$117.70 per hour (total \$324.95).

INTERNAL USE ONLY

Name (Last, First, Initial)		Employee #	Division
From (Date & Time)	To (Date & Time)	Total Hours Worked	_____ Comp Time Requested _____ Overtime Requested
Employee Signature: _____ Date: _____			
AUTHORIZED _____ Comp time _____ Overtime _____ Immediate Supervisor _____ Date _____		APPROVALS _____ Division Manager _____ Date _____ Executive Director _____ Date _____	



Structural Calculations
Roof Seismic Strengthening - Partial
Concrete Tilt-up Building
1917 E St Andrew Place (Bldg F)
Santa Ana, CA

R-Voit-01F



RECEIVED

NOV 07 2011

City of Santa Ana

Revision
0

October 11, 2011

27 Orchard, Suite 200
Lake Forest, CA 92630
Phone: (949) 716-9990 Fax: (949) 716-9997
www.national-eng.com

The structural calculations contained in this report relate only to the structure and site for which they were prepared. Referenced building codes, site-specific parameters for wind and seismic design, and any cited material/component design standards are current only for the governmental agency with jurisdiction over the design and construction of the proposed structure at the time the report was published. Some information utilized in the structural calculations may have been received from outside sources such as third party site development coordinators, geotechnical engineering reports, pre-engineered component manufacturers, or engineering/trade organizations. NEC is not responsible for the accuracy and/or changes to any information utilized herein as provided by outside sources.

Scope

THE PROJECT CONSISTS OF A LIMITED SEISMIC STRENGTHENING OF AN EXISTING INDUSTRIAL BUILDING. THE SCOPE OF THE PROJECT IS LIMITED TO THE REQUIREMENTS OF CHAPTER A2 OF THE INTERNATIONAL EXISTING BUILDING CODE AT THE ROOF LEVEL ONLY INCLUDING WALL ANCHORAGE, CONTINUITY TIES, AND DRAGS.

THERE IS NO MEZZANINE

THE BUILDING CONSISTS OF A CONCRETE TILT-UP BUILDING WITH A PANELIZED ROOF CONSISTING OF A PLYWOOD DIAPHRAGM SUPPORTED ON 2X RAFTERS SUPPORTED ON 4X PURLINS THAT SPAN TO GLULAM BEAMS. ORIGINAL BUILDING AGE AND BUILDING CODE WAS NOT DETERMINED BUT IS REPORTED TO PRE-DATE THE MID-1970'S.

THERE IS CURRENTLY NO KNOWN JURISDICTIONAL MANDATE FOR SEISMIC STRENGTHENING FOR THIS BUILDING.

STORY DRIFT, DIAPHRAGM STRENGTH, WALL STRENGTHS, ETC. ARE OUT OF SCOPE AND NOT ADDRESSED.

3404.5 Voluntary seismic improvements. Alterations to existing structural elements or additions of new structural elements that are not otherwise required by this chapter and are initiated for the purpose of improving the performance of the seismic force-resisting system of an *existing structure* or the performance of seismic bracing or anchorage of existing nonstructural elements shall be permitted, provided that an engineering analysis is submitted demonstrating the following:

1. The altered structure and the altered nonstructural elements are no less in compliance with the provisions of this code with respect to earthquake design than they were prior to the *alteration*.
2. New structural elements are detailed and connected to the existing structural elements as required by Chapter 16.
3. New or relocated nonstructural elements are detailed and connected to existing or new structural elements as required by Chapter 16.
4. The alterations do not create a structural irregularity as defined in ASCE 7 or make an existing structural irregularity more severe.

JOB NAME: 1917 E St Andrew Place (Bldg F)	JOB NO: R-Voit-01F	SHEET NO: G - 2
	ENGINEER: MEO'	DATE: Oct '11
ANALYSIS: General		

Design Criteria

I. Code

A. Chapter A2 of the 2009 International Existing Building Code

II. Lateral Loads

Wind - Not Applicable

III. Allowable Stresses for New Materials

A. Structural Masonry

Walls..... Not Applicable

B. Concrete

(E) Wall panels & Columns f'c = 2,500 psi at 28 Days Assumed
 (E) Slab on grade..... f'c = 2,000 psi at 28 Days Assumed

C. Reinforcing Steel

Slabs & Footings ASTM A615, Fy = 60 ksi
 Welded Bars ASTM A706, Fy = 60 ksi

D. Structural Steel

Structural Shapes (W, M, etc.) ASTM A992, Fy = 50 ksi
 Tubes ASTM A500, Fy = 46 ksi
 Miscellaneous ASTM A36, Fy = 36 ksi
 Pipe ASTM A53, Fy = 35 ksi

E. Timber

Sawn Lumber..... Douglas Fir Larch
 Glued Laminated Lumber..... Douglas Fir Larch

F. Soil

Based On Report By:

N/A

33.722733,-117.841008

from Internet

Conterminous 48 States
 2009 International Building Code
 Latitude = 33.722733
 Longitude = -117.84100800000002
 Spectral Response Accelerations Ss and S1
 Ss and S1 = Mapped Spectral Acceleration Values
 Site Class B - $F_a = 1.0$, $F_v = 1.0$
 Data are based on a 0.01 deg grid spacing

Period	S_a
(sec)	(g)
0.2	1.453 (Ss, Site Class B)
1.0	0.513 (S1, Site Class B)

Conterminous 48 States
 2009 International Building Code
 Latitude = 33.722733
 Longitude = -117.84100800000002
 Spectral Response Accelerations SMs and SM1
 $SMs = F_a \times Ss$ and $SM1 = F_v \times S1$
 Site Class D - $F_a = 1.0$, $F_v = 1.5$

Period	S_a
(sec)	(g)
0.2	1.453 (SMs, Site Class D)
1.0	0.770 (SM1, Site Class D)

Conterminous 48 States
 2009 International Building Code
 Latitude = 33.722733
 Longitude = -117.84100800000002
 Design Spectral Response Accelerations SDs and SD1
 $SDs = 2/3 \times SMs$ and $SD1 = 2/3 \times SM1$
 Site Class D - $F_a = 1.0$, $F_v = 1.5$

Period	S_a
(sec)	(g)
0.2	0.968 (SDs, Site Class D)
1.0	0.513 (SD1, Site Class D)

JOB NAME: 1917 E St Andrew Place (Bldg F)	JOB NO: R-Voit-01F	SHEET NO: L - 1
	ENGINEER: MEO'	DATE: Oct '11
ANALYSIS: Lateral		

Seismic Design Criteria

Per IBC 2009

Earthquake Loads per CBC 2010 & IBC 2009 Sections 1613 & ACSE 7-05 Sections 12-14

$E = \rho E_H + E_V$	$\rho = 1.00$	Redundancy Factor	ASCE 7 12.3.4
$E_M = \Omega_o \times E_H$	$\Omega_o = 2.00$	Overstrength Factor	ASCE 7 Table 12.2-1 (2.5 minus 0.5 for flex diaphragm per foot note "g") Shall not be less than 2.0
$E_V = 0.2 \times S_{DS} \times D$	$E_V = 0.19 D$	Vertical Component	ASCE 7 Section 12.4.2.2

Seismic Base Shear per CBC 2010 & IBC 2009 Sections 1613-1622

		Description	Reference
	$S_S = 1.453$	Spectral acceleration short period	IBC Map 1613.5(1)
	$S_1 = 0.513$	Spectral acceleration 1 sec period	IBC Map 1613.5(2)
	Soil Site Class = D	Soil Profile Type	from Geotech report
	calc'ed $F_a = 1.00$	Site coefficient, Site Class D	IBC Table 1613.5.3(1)
	calc'ed $F_V = 1.50$	Site coefficient, Site Class D	IBC Table 1613.5.3(2)
	$S_{MS} = F_a S_S = 1.45$	Short period max spectral response	
	$S_{M1} = F_V S_1 = 0.77$	1 sec period max spectral response	
	$S_{DS} = 2/3 S_{MS} = 0.97$	Design short period max spectral response	IBC EQ. 16-39
	$S_{D1} = 2/3 S_{M1} = 0.51$	Design 1 sec period max spectral response	IBC EQ. 16-40
Bldg height 22 ft	T = 0.20 sec	Fundamental Period of shearwall	ASCE 7 EQ. 12.8-7
	$T_O = 0.2 S_{D1} / S_{DS} = 0.11$ sec		
	$T_S = S_{D1} / S_{DS} = 0.53$ sec		
	S = 0.969	Design spectral response acceleration	ASCE 7 Table 12.8-1
	Seismic Use Group = II	Group II, typical	ASCE 7 Table 1-1
	Seismic Design Category = D	ASCE 7 TableS 11.6-1 and 11.6-2	
	I = 0.75	Importance Factor	IEBC A206.1
	Plan Structural Irregularities = None	None	
	Vertical Structural Irregularities = None	None	
Intermediate Precast Concrete Bearing Wall	R = 4.0	Response Modification Coefficient	ASCE 7 Table 12.2-1
	$C_d = 4.0$	Deflection Amplification Factor	ASCE 7 Table 12.2-1
Intermediate Precast Concrete Bearing Walls			
	$C_S = S_{DS} I / R = 0.182 W$	Building Base Shear	ASCE 7 EQ. 12.8-2
	$C_S \text{Max} = S_{D1} I / (R T) = 0.47 W$	Maximum Base Shear	ASCE 7 EQ. 12.8-3
	$C_S \text{Min} = 0.5 S_1 I / R = 0.05 W$	Minimum Base Shear ($S_1 > .6g$)	ASCE 7 EQ. 12.8-6
	Ft = 0.07 T V = 0.000 W	Concentrated Top Force	ASCE 7 EQ. 12.14-13
	V = 0.182 W + Ft	Governing Base Shear	Allowable = 0.130 W
		for flexible diaphragms	

Seismic Diaphragm Shear per CBC 2007 & IBC 2006 Section 1620.1.5

From above	0.182 W	Based on Lateral System	Governs
Minimum $F_P = 0.2 S_{DS} I$	0.145 W	Minimum	
$F_P = 0.4 S_{DS} I$	0.291 W	Max Diaphragm Accel	
	0.182 W	Governing Diaphragm acceleration	Allowable = 0.130 W

Seismic Load to Structural Elements per CBC 2010 & IBC 2009 Section 1620.2 (Wall Anchorage)


$F_P = 0.8 S_{DS} I$	0.581 W	Category C & Higher	Allowable = 0.415 W
----------------------	----------------	---------------------	----------------------------

*Note - All seismic coefficients are ULTIMATE and must be divided by a factor of 1.4 for Allowable Stress Design.

JOB NAME: 1917 E St Andrew Place (Bldg F)	JOB NO: R-Voit-01F	SHEET NO: L- 2
	ENGINEER: MEO'	DATE: Oct '11
ANALYSIS: Lateral		

Tributary Mass for Wall Anchorage per Chapter A2 of IEBC

Purlins - Worst Case

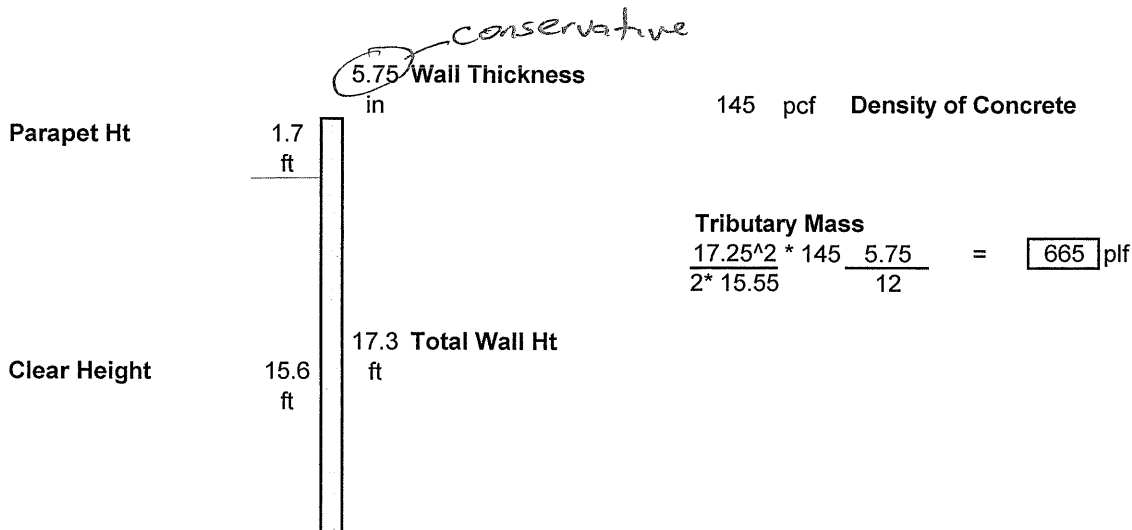

Wall Anchorage Force per 2010 CBC - Section 12.11 of ASCE 7-05

$F_p = 0.8 S_{ds} I W$
 $I = 0.75$ linked per A206.1
 $S_{ds} = 0.97$ linked
 $F_p = 0.8 S_{ds} I W = 0.58 W = 386 \text{ plf}$ Equation 12.11-1
 $0.1 W = 66 \text{ plf}$ Section 12.11.1
 $400 S_{ds} I = 291 \text{ plf}$ Section 12.11.2 b
 280 Section 12.11.2 c

Governs: 386 plf **Strength Level**
276 plf **Allowable Level**

Steel Elements - use **Allowable Stress Design** and apply a Load Factor of 1.0 per Section A206.2
Steel Demand $276 \text{ plf} \times 1.0 = \text{276 plf}$

Concrete Elements - use **Strength Design** and apply a Load Factor of 1.0 per Section A206.2
Concrete Demand $386 \text{ plf} \times 1.0 = \text{386 plf}$

Wood Elements - use **Allowable Stress Design** with no additional Load Factors per Section A206.2
Wood Demand $276 \text{ plf} \times 1.0 = \text{276 plf}$

	JOB NO: R-Voit-01F	SHEET NO: L- 3
JOB NAME: 1917 E St Andrew Place	ENGINEER: MEO'	DATE: Oct '11
ANALYSIS: Lateral		

Purlin Wall Anchorage & Continuity Ties

Purlins - Worst Case

Purlin Spacing:	8.0 ft				
Continuity Tie Spacing	24.0 ft				
Purlin Width	3.5 in	276 plf	2208 lbs	Steel Demand	Wood Type DF #1 (assumed)
Purlin Depth (Min)	13.25 in	386 plf	3091 lbs	Concrete Demand	per UBC 1982 (assumed)
Purlin Span	24.0 ft	276 plf	2208 lbs	Wood Demand	tension ft: 1200 psi
					flexural fb: 1400 psi

Epoxy Check

Demand 3091 lbs 8.0 ft - max spacing of **concrete** demand
 Capacity of Hilti HIT RE-500 SD based on PROFIS calculation for a **PAIR** of epoxy anchors
 Assumes 5.50 inch thick wall with 4.00 inch embedment with 0.625 inch diameter rod and
 8.0 inch spacing of anchors. Please see calc sheets
Capacity 4150 lbs **OK**

Zone 4 Hardware Check - Wall Anchor

Demand 2208 lbs 8.0 ft - max spacing of **steel** demand
 Capacity of Zone 4 Hardware from City of LA RR# 25334 for a pair of hardware Please see Zone 4 Table
 Assumes 3.50 inch thick member 13.25 inch deep member (min)
 Hardware **T2 43-5 (Pair)** Hardware **T2 24-6 (Pair)**
Capacity 5830 lbs **OK** Capacity 5071 lbs **OK**
 ICC ICC

Zone 4 Hardware Check - Continuity Tie

Demand 6623 lbs 24.0 ft - max spacing of **steel** demand
 Capacity of Zone 4 Hardware from City of LA RR# 25334 for a pair of hardware Please see Zone 4 Table
 Assumes 3.50 inch thick member 13.25 inch deep member (min)
 Hardware **T2 44-6 (Pair)** Hardware
Capacity ##### lbs **OK** Capacity lbs **OK**
 ICC

Subdiaphragm Check to Purlin Continuity Ties

Demand 4416 lbs 2 purlin bays of **wood** demand into subdiaphragm since next wall anchor is on CT line
 Assumes 24.0 ft deep subdiaphragm
 92 plf **Resulting Subdiaphragm Shear Demand**
 System **1/2" CDX plywood with 8d @ 6" oc** assumed - worst case
Capacity 270 lbs **OK**


Check Purlin Continuity Tie for Combined Gravity and Axial Seismic

Axial Wood Demand 6623 lbs 24.0 ft - max spacing of **wood** demand
 Resulting axial stress for 3.5 in. x 13.25 in. **142.8 psi**
 Assumed member DL **12.0 psf** resulting in uniform loa **96 plf** for a span **24.0 ft**
 For a max moment c **82944 lb-in** on a section modulus **102.4 in^3**
 Resulting flexural stress for 3.5 in. x 13.25 i **809.9 psi**
Unity Check axial bending
 $\frac{143}{1200} + \frac{809.9}{1400} = 0.70 < 1.6$ **OK**

JOB NAME: 1917 E St Andrew Place (Bldg F)	JOB NO: R-Voit-01F	SHEET NO: L- 4
	ENGINEER: MEO'	DATE: Oct '11
ANALYSIS: Lateral		

Tributary Mass for Wall Anchorage per Chapter A2 of IEBC

Subpurlins - Worst Case

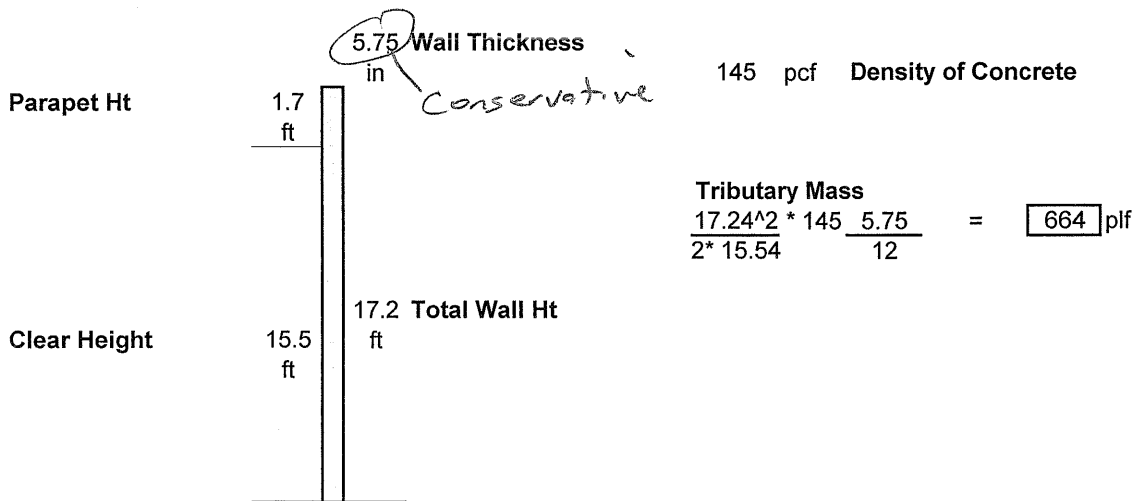

Wall Anchorage Force per 2010 CBC - Section 12.11 of ASCE 7-05

Fp = 0.8 Sds I W
 I = 0.75 linked per A206.1
 Sds = 0.97 linked

Fp = 0.8 Sds I W = 0.58 W = 386 plf Equation 12.11-1
 0.1 W = 66 plf Section 12.11.1
 400 Sds I = 291 plf Section 12.11.2 b
 280 280 plf Section 12.11.2 c

Governs: 386 plf Strength Level
276 plf Allowable Level

Steel Elements - use **Allowable Stress Design** and apply a Load Factor of 1.0 per Section A206.2
Steel Demand 276 plf x 1.0 = 276 plf

Concrete Elements - use **Strength Design** and apply a Load Factor of 1.0 per Section A206.2
Concrete Demand 386 plf x 1.0 = 386 plf

Wood Elements - use **Allowable Stress Design** with no additional Load Factors per Section A206.2
Wood Demand 276 plf x 1.0 = 276 plf

	JOB NO: R-Voit-01F	SHEET NO: L- 5
JOB NAME: 1917 E St Andrew Place	ENGINEER: MEO'	DATE: Oct '11
ANALYSIS: Lateral		

Subpurlin (Rod) Wall Anchorage & Continuity Ties

Subpurlins - Worst Case

Anchor Line Trib:	6.0 ft			Loading per Anchor Line (based on spacing)
Purlin Width	1.5 in	276 plf	1655 lbs	Steel Demand
Purlin Depth (Min)	3.5 in	386 plf	2317 lbs	Concrete Demand
Wood Type	DF #1 (assumed)	276 plf	1655 lbs	Wood Demand

Epoxy Check

Demand	2317 lbs	6.0 ft - max trib of <i>concrete</i> demand
Capacity of Hilti HIT RE-500 SD based on PROFIS calculation for a SINGLE epoxy anchor		
Assumes	5.50 inch thick wall with	4.00 inch embedment with 0.625 inch diameter rod and
Capacity	2600 lbs	OK Please see calc sheets

Development of Anchorage Force into Subdiaphragm - assumes field nailing

Demand	1655 lbs	1 # of rods of <i>wood</i> demand adjacent to analyzed rafter line
Assumes	16.0 ft deep subdiaphragm	
52 plf	Resulting Subdiaphragm Shear Demand (note: load split between two rafter lines)	
System	1/2" CDX plywood with 8d @ 12" oc assumed - worst case - field nailing	
Capacity	135 lbs	OK

Subdiaphragm Check to GLB Continuity Ties

Demand	6620 lbs	4 # of rods of <i>wood</i> demand since the GLB wall anchors are not in subdiaphragm
Assumes	16.0 ft deep subdiaphragm	
207 plf	Resulting Subdiaphragm Shear Demand	
System	1/2" CDX plywood with 8d @ 6" oc assumed - worst case	
Capacity	270 lbs	OK

Zone 4 Hardware Check - Continuity Tie on GLBs

Demand	7172 lbs	26.0 ft - max spacing of <i>steel</i> demand
Capacity of Zone 4 Hardware from City of LA RR# 25334 for a pair of hardware		Please see Zone 4 Table
Assumes	5.125 inch thick member 11.25 inch deep member (min)	
Hardware	T2 44-6 (Pair)	Hardware
Capacity	##### lbs	OK Capacity lbs OK
	ICC	

Zone 4 - ICC report #5302

TABLE 2—CT CONTINUITY TIE AND T2 TENSION TIE/HOLD-DOWN TENSION DESIGN CAPACITIES FOR PAIRED CONNECTORS
(Design Capacities are based upon Allowable Stress Design)

L-6
5 of 21

CT/T2 Paired Connection (PC) System						CT/T2 Paired Connection (PC) Design Capacities (pounds) ($C_D = 1.33$) ^{1,2,3,4,5,9,10,12}									
PC Model Quantity & CT/T2	A307 Bolts Quantity & Diam. (inches)	Min. End Distance ⁶ (inches)	Anchor Rods ^{7,11} ($C_D = 1.33$) A36 ($F_u = 58,000$ psi)		b^8 min. width (depth) (inches)	t (inches), length of bolt in wood member (thickness)									
			Diam. (inches)	Capacity (pounds)		1.50	2.50	3.00	3.50	5.125	5.50	7.50			
(2) 24-5	(2) 3/8	2 5/8	(2) 5/8	15630	3.5	2095	2682								
(2) 43-5	(4) 3/8				3.5	4190	5630								
(2) 63-5	(6) 3/8				3.5	6270	8746								
					5.5	6264									
					3.5	6270	8783	10539	11631						
					5.5	17550	11681	11681							
(2) 24-6	(2) 1/2	3 1/2	(2) 3/4	22503	3.5	2763	4655	5071							
(2) 44-6	(4) 1/2				3.5	5055	8424	10109	10365						
					5.5	5586	9310	10395							
(2) 64-6	(6) 1/2				3.5	6055	8424	10109	11794	14967	15548				
					5.5	7363	11227	14726	15548	15548					
					7.25	8376	13665	15548							
(2) 84-6	(6) 1/2				3.5	6055	8424	10109	11794	14967	16082	20731			
					5.5	7363	11227	14726	17181	20731	20731				
					7.25	9206	15343	18411	20731						
					9.25	10962	18270	20731							
					11.25	11172	18620								
(2) 28-6	(2) 5/8	4 3/8	(2) 3/4	22503	5.5	3491	5819	6883	7623						
(2) 46-6	(4) 5/8				5.5	6683	11638	13665	16198						
					5.5	7177	11981	14353	16748	24294					
(2) 66-7	(6) 5/8				7.25	9034	16059	18087	21078						
					9.25	10474	17455	20948	24294						
					5.5	7177	11981	14353	16748	27303	28043	32392			
	(6) 5/8		(2) 1	36968	7.25 / 7.5	8604	15058	18087	21078	32392	32392				
					9.25	11004	18007	21609	25210						
					11.25	12117	20194	24233	28272						
					13.25	12870	21616	25939	30293						
(2) 28-8	(2) 3/4	5 1/4	(2) 3/4	22503	5.5	4190	6683	6379	9776	11409					
(2) 48-8	(4) 3/4				5.5	6990	11650	13681	16311	23322					
					7.25	8379	13665	16758	19651						
					5.5	6960	11650	13681	16311	18311	26360	26286	34663		
					7.25 / 7.5	8862	14788	17729	20677	34663	34663				
					9.25	10847	17745	21294	24842						
	(6) 3/4		(2) 1 1/8	50807	11.25	11873	16555	23845	27837						
					13.25	12569	20948	26137	29327						

For SI: 1 inch = 25.4 mm, 1 pound = 4.45 N, 1 psi = 6.89 kPa

TABLE 2—CT CONTINUITY TIE AND T2 TENSION TIE/HOLD-DOWN TENSION DESIGN CAPACITIES FOR PAIRED CONNECTORS—(Continued)

CT/T2 Paired Connection (PC) System						CT/T2 Paired Connection (PC) Design Capacities (pounds) ($C_D = 1.33$) ^{1,2,3,4,5,9,10,12}							
PC Model Quantity & CT/T2	A307 Bolts Quantity & Diam. (inches)	Min. End Distance ⁶ (inches)	Anchor Rods ^{7,11} ($C_D = 1.33$) A36 ($F_u = 58,000$ psi)		b^8 min. width (depth) (inches)	t (inches), length of bolt in wood member (thickness)							
			Diam. (inches)	Capacity (pounds)		1.50	2.50	3.00	3.50	5.125	5.50	7.50	
(2) 27-8	(2) 7/8	6 1/8	(2) 1	36968	5.5	4838	8148	9776	11405	15529			
(2) 47-8	(4) 7/8				5.5	6804	11340	13609	15878	25557	27534	31744	
					7.25 / 7.5	8889	14482	17379	20275	31744	31744		
					9.25	9776	16283	18551	22810				
(2) 68-8	(2) 1				5.5	5589	9310	11172	13034	19098	20282		
					5.5	6817	11029	13235	15441	24954	26780	36518	
(2) 48-9	(4) 1	7	(2) 1 1/8	50807	7.25 / 7.5	8517	14193	17035	19974	34765	36850	41451	
					9.25/6.5	10331	17219	20683	24108	37670	40664		
					11.25	11172	18620	22344	26058	38171			
					5.5	6817	11029	13235	15441	24954	26780	36518	
					7.25 / 7.5	8517	14193	17035	19974	34765	36850	52977	
					9.25/6.5	10331	17219	20683	24108	37670	41681	62192	
(2) 68-10	(6) 1	7	(2) 1 1/4	62470	11.25/11.5	11686	18477	23379	27268	48872	51536		
					13.25/13.5	12563	20971	25165	29359	54953	60183		
					>15.5			NOT APPLICABLE		57257	61448		
					5.5	6817	11029	13235	15441	24954	26780	36518	
					7.25 / 7.5	8517	14193	17035	19974	34765	36850	52977	
					9.25/6.5	10331	17219	20683	24108	37670	41681	62192	

For SI: 1 inch = 25.4 mm, 1 pound = 4.45 N, 1 psi = 6.89 kPa

- Design capacities have been increased by a 1.33 load duration factor (C_D) in accordance with Section 1612.3.3 of the UBC. Wood member design capacities include consideration of tensile stresses.
- Maximum bolt design capacities in the minimum size wood member are shown by ##.
- Maximum bolt design capacities are achieved in smaller size wood members in areas shown by c.
- Design capacities controlled by the net section tension capacity of the wood member are shown by ##.
- Maximum design capacities of wood members are achieved with connectors using fewer and/or smaller bolts or both in areas shown by ##.
- The minimum end distance, from the end of the wood member to the centerline of the first CT/T2 bolt, is seven (7) CT/T2 bolt diameters. End distance may be increased with no decrease in design capacities.
- The capacity of the concrete anchor must be equal to or greater than the design capacity of the connector being specified.
- b = width (depth) of the wood member.
- The design engineer shall check the wood member's design capacity for use conditions subject to additional loads (i.e. roof and floor dead loads). The applicable formulae and allowable stresses, per the 1991 NDS, should be used when calculating design capacities for wood members subject to a combination of bending about both axes and axial tension or compression.
- Table is based on wood type and grade, Douglas Fir-Larch, No. 2 typ., No. 1 @ 5 x 6 and larger.
- For anchor rod design capacities of ASTM A163-B7, A364-BD and A440 the A36 ($F_u = 58.0$ ksi) tension capacities shown in the tables should be multiplied by the following factors:

Anchor Rod (Diameter)	$F_{u min}$ (ksi)	Factor
ASTM A163-B7 (5/8 - 1 1/2)	125.0	2.155
ASTM A364-BD (5/8 - 1 1/2)	150.0	2.588
ASTM A440 (5/8 - 1)	120.0	2.069
ASTM A440 (1 1/8 - 1 1/2)	105.0	1.810

12 Design capacities are based upon allowable stress design.

ER-5302 Page 7 of 21

	JOB NO: R-Voit-01F	SHEET NO: L-7
JOB NAME: 1917 E St Andrew Place (Bldg F)	ENGINEER: MEO	DATE: Oct '11
ANALYSIS: General		

Wall Angle Brackets at Purlins and GLBS

GLB Wall anchorage

FEMA & COLA require that the effects of the pilaster be considered.

Regular Trib = 4'

Trib w/ pilaster effect = assume double = 8'

↳ This would be 1/3 of panel Length (Conservative)

OK


Epoxy

based on previous calc, each anchor good for 4.0' of Trib
we will be providing a pair of anchors (each side)
so capacity is 8'

OK

Hardware

due to panel joint & other obstructions, provide angle kickers

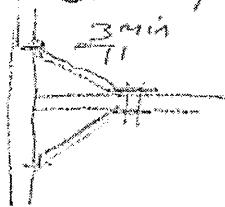

$$\text{Load } 8' \times 465 \text{ plf} = \frac{3720 \text{ \#}}{2 \text{ braces}} = 1860 \text{ \#/brace}$$

increase due to skew

$$1860 \times \frac{\sqrt{1^2 + 3^2}}{3} = 1960 \text{ \#}$$

L3x3x 1/4 w/ 1960# tension/compression

per AISC 13th p.4-173 Table 4-11

capacity for 9' long 6.33^k < 1.96^k

OK

Hardware bolts

$$\frac{1860 \text{ \#}}{2 \text{ bolts}} = 930 \text{ \# in } 5/8" \text{ GLB}$$

NDS p.90 Table 11I 5/8" stl, double shear, E11, DF, 5/8" ϕ

capacity 2440#

$$\frac{3720 \text{ \#}}{2440 \text{ \#/bolt}} = 1.5 \Rightarrow \underline{2 \text{ bolts}}$$

(2) 5/8" ϕ 11B
req'd


PROFIS Anchor 2.1.4


www.hilti.us

Company: National Engineering & Consulting
 Specifier: MEO'
 Address:
 Phone | Fax: - | -
 E-Mail:

Page: 1
 Project: 5.5" Thick Concrete
 Sub-Project | Pos. No.:
 Date: 7/6/2011

Specifier's comments:
Input data

Anchor type and diameter: HIT-RE 500-SD + HAS, 5/8
 Effective embedment depth: $h_{e,req} = 4.000$ in. ($h_{e,inst} = 4.000$ in.)
 Material: ASTM F 568M Class 5.8
 Evaluation Service Report: ESR 2322
 Issued | Valid: 4/1/2010 | -
 Proof: design method ACI 318 / AC308
 Stand-off installation: $e_p = 0.000$ in. (no stand-off); $t = 0.500$ in.
 Anchor plate: $l_p \times l_p \times t = 20.000 \times 20.000 \times 0.500$ in. (Recommended plate thickness: not calculated)
 Profile: S shape (AISC); (L x W x T x FT) = 3.000 in. x 2.330 in. x 0.170 in. x 0.260 in.
 Base material: cracked concrete, 2500, $f'_c = 2500$ psi; $h = 5.500$ in., Temp. short/long: 70/70°F
 Installation: hammer drilled hole, installation condition: dry
 Reinforcement: tension: condition B, shear: condition B; no supplemental splitting reinforcement present
 edge reinforcement: > No. 4 bar
 Seismic loads (cat. C, D, E, or F): yes (D.3.3.5)

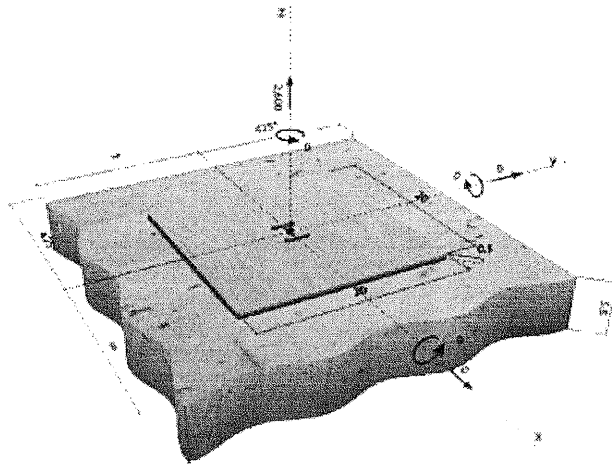Geometry [in.] & Loading [lb, in.-lb]

Proof | Utilization (Governing Cases)

Loading	Proof	Design values [lb]		Utilization [%]	Status
		Load	Capacity	β_u/β_v	
Tension	Bond Strength	2600	2601	100 / -	OK
Shear	-	-	-	- / -	-

Warnings

- Please consider all details and hints/warnings given in the detailed report!

Fastening meets the design criteria!

Input data and results must be checked for agreement with the existing conditions and for plausibility!

PROFIS Anchor (c) 2003-2009 Hilti AG, FL-9494 Schaan Hilti is a registered Trademark of Hilti AG, Schaan



www.hilti.us

PROFIS Anchor 2.1.4

Company: National Engineering & Consulting
 Specifier: MEO
 Address:
 Phone / Fax: - / -
 E-Mail:


Page: 1
 Project: 5.5" Thick Concrete
 Sub-Project / Pos. No.:
 Date: 7/8/2011

Specifier's comments:

Input data

Anchor type and diameter: HIT-RE 500-SD + HAS, 5/8
Effective embedment depth: $h_{e,act} = 3.719$ in. ($h_{e,req} = 4.000$ in.)
Material: ASTM F 568M Class 5.8
Evaluation Service Report: ESR 2322
Issued / Valid: 4/1/2010 / -
Proof: design method ACI 318 / AC308
Stand-off installation: $e_s = 0.000$ in. (no stand-off); $t = 0.500$ in.
Anchor plate: $l_p \times l_p \times t = 4.000 \times 16.000 \times 0.500$ in. (Recommended plate thickness: not calculated)
Profile: S shape (AISC); (L x W x T x FT) = 3.000 in. x 2.330 in. x 0.170 in. x 0.260 in.
Base material: cracked concrete, 2500, $f'_c = 2500$ psi; $h = 5.500$ in., Temp. short/long: 70/70°F
Installation: hammer drilled hole, installation condition: dry
Reinforcement: tension: condition B, shear: condition B; no supplemental splitting reinforcement present
 edge reinforcement: > No. 4 bar
 yes (D.3.3.5)
Seismic loads (cat. C, D, E, or F): yes (D.3.3.5)

Geometry [in.] & Loading [lb, in.-lb]

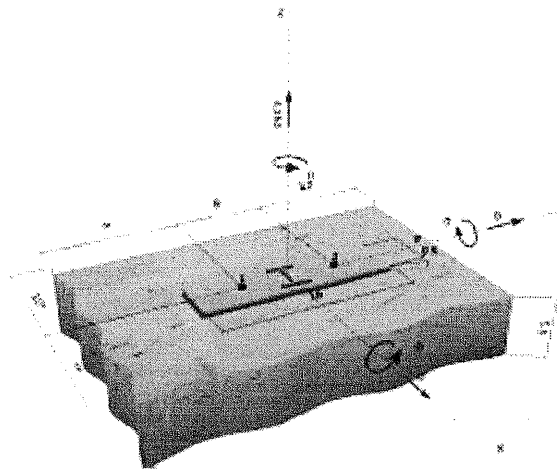

Proof / Utilization (Governing Cases)

Loading	Proof	Design values [lb]		Utilization [%]	Status
		Load	Capacity	β_u/β_s	
Tension	Bond Strength	4150	4152	100 / -	OK
Shear	-	-	-	- / -	-

Warnings

- Please consider all details and hints/warnings given in the detailed report!

Fastening meets the design criteria!

input data and results must be checked for agreement with the existing conditions and for plausibility!
 PROFIS Anchor (c) 2003-2009 Hilti AG, FL-8484 Schaan. Hilti is a registered trademark of Hilti AG, Schaan.



www.hilti.us

PROFIS Anchor 2.1.4

Company: National Engineering & Consulting
 Specifier: MEO
 Address:
 Phone / Fax: - / -
 E-Mail:


Page: 1
 Project: 5.5" Thick Concrete
 Sub-Project / Pos. No.:
 Date: 7/8/2011

Specifier's comments:

Input data

Anchor type and diameter: HIT-RE 500-SD + HAS, 5/8
Effective embedment depth: $h_{w,act} = 3.768$ in. ($h_{w,req} = 4.000$ in.)
Material: ASTM F 568M Class 5.8
Evaluation Service Report: ESR 2322
Issued / Valid: 4/1/2010 / -
Proof: design method ACI 318 / AC308
Stand-off installation: $e_s = 0.000$ in. (no stand-off); $t = 0.500$ in.
Anchor plate: $l_p \times l_y \times t = 4.000 \times 16.000 \times 0.500$ in. (Recommended plate thickness: not calculated)
Profile: S shape (AISC); (L x W x T x FT) = 3.000 in. x 2.330 in. x 0.170 in. x 0.260 in.
Base material: cracked concrete, 2500, $f'_c = 2500$ psi; $h = 5.500$ in., Temp. short/long: 70/70°F
Installation: hammer drilled hole, installation condition: dry
Reinforcement: tension: condition B, shear: condition B; no supplemental splitting reinforcement present
 edge reinforcement: > No. 4 bar
Seismic loads (cat. C, D, E, or F): yes (D.3.3.5)

Geometry [in.] & Loading [lb, in.-lb]

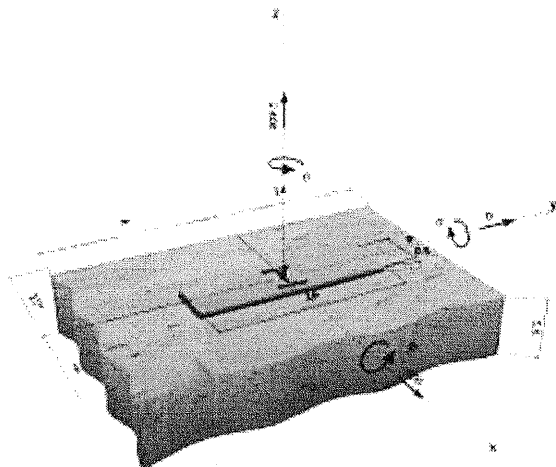

Proof / Utilization (Governing Cases)

Loading	Proof	Design values [lb]		Utilization [%]	Status
		Load	Capacity	β_u/β_s	
Tension	Bond Strength	2400	2445	98 / -	OK
Shear	Steel Strength (without lever arm)	900	4129	- / 22	OK

Loading	β_u	β_s	ζ	Utilization $\beta_{u,s}$ [%]	Status
Combined tension and shear loads	0.980	0.218	-	100	OK

Warnings

• Please consider all details and hints/warnings given in the detailed report!

Fastening meets the design criteria!

input data and results must be checked for agreement with the existing conditions and for plausibility!

PROFIS Anchor (c) 2003-2009 Hilti AG, FL-9494 Schaan. Hilti is a registered trademark of Hilti AG, Schaan.

CITY OF SANTA ANA
PLAN CHECK - CHECKLIST

JOB ADDRESS: Ritchey, St Andrew, Glenwood
TRACKING #: 10173635-37 DATE: 11-7-11

FOR PLANCHECK STATUS CALL (714) 647-5800

PLEASE INITIAL EACH ITEM BELOW

1. I agree to pay a plancheck fee established for this project with the understanding that this payment is not a guarantee that a permit will be issued and that this fee is not refundable once a plancheck has commenced.
2. I understand that I may request an "Accelerated Plancheck" at an additional cost to me. This plancheck will be performed by an in-house plan checker with the intention of reducing plancheck time for the Building & Safety Division.
3. I understand that the project valuation (from which plancheck and permit fees are calculated) will be reviewed during the plancheck process and that said valuation shall be adjusted up or down in accordance with established fee computation regulations.
4. I understand that I shall submit separate plans, applications and plancheck fees for the following when plan check is required:
- a. Electrical Plans - 2 complete sets
 - b. Plumbing Plans - 3 complete sets
 - c. Mechanical Plans - 2 complete sets
 - d. Grading Plans - 3 complete sets
5. I understand that I shall visit the Public Works Department to verify whether a field inspection of the property is required. I understand that prior to the issuance of the Building permit I am required to obtain Public Works Agency approval if my project valuation exceeds \$30,000 or has added plumbing fixtures, or added bedrooms, or exceeds 500 sq.ft.

AGREED TO BY APPLICANT OR AGENT

Applicant's Signature: Michael Santillan
Print Name Michael Santillan Address 27 Orchard, Lake Forest
Telephone Number TH 803-8454 Fax 949-716-9997

FOR OFFICE USE ONLY: "Checklist of items discussed" APPROVALS & FEES REQUIRED: Y/N

- | | | |
|--|---|--|
| 1. <input checked="" type="checkbox"/> Planning Department | 7. <input checked="" type="checkbox"/> Title 24 (Energy) | 14. <input checked="" type="checkbox"/> Constr. Act. Req. |
| 2. <input checked="" type="checkbox"/> Public Works Agency | 8. <input checked="" type="checkbox"/> Title 24 (Disabled Access) | 15. <input checked="" type="checkbox"/> Res. Dev. Fees |
| 3. <input checked="" type="checkbox"/> Fire Department | 9. <input checked="" type="checkbox"/> Roof Mounted Equip. | 16. <input checked="" type="checkbox"/> SMIP |
| 4. <input checked="" type="checkbox"/> Police Department | 10. <input checked="" type="checkbox"/> List of Subcontr. | 17. <input checked="" type="checkbox"/> Microfilming |
| 5. <input checked="" type="checkbox"/> School District | 11. <input checked="" type="checkbox"/> Bldg. Pmt. Info. | 18. <input checked="" type="checkbox"/> Const. Debris Recyc. |
| 6. <input checked="" type="checkbox"/> Health Department | 12. <input checked="" type="checkbox"/> Summary of Appr. Req. | 19. <input checked="" type="checkbox"/> FCWP Surcharge |
| | 13. <input checked="" type="checkbox"/> FY Information | 20. <input checked="" type="checkbox"/> LOA/Owner-Builder Ver. |

PERMIT TECHNICIAN K Hernandez



Structural Calculations
Roof Seismic Strengthening - Partial
Concrete Tilt-up Building
1917 E St Andrew Place (Bldg F)
Santa Ana, CA

R-Voit-01F

R E C E I V E D

NOV 07 2011

City of Santa Ana



Revision
0

October 11, 2011

27 Orchard, Suite 200
Lake Forest, CA 92630
Phone: (949) 716-9990 Fax: (949) 716-9997
www.national-eng.com

The structural calculations contained in this report relate only to the structure and site for which they were prepared. Referenced building codes, site-specific parameters for wind and seismic design, and any cited material/component design standards are current only for the governmental agency with jurisdiction over the design and construction of the proposed structure at the time the report was published. Some information utilized in the structural calculations may have been received from outside sources such as third party site development coordinators, geotechnical engineering reports, pre-engineered component manufacturers, or engineering/trade organizations. NEC is not responsible for the accuracy and/or changes to any information utilized herein as provided by outside sources.

Scope

THE PROJECT CONSISTS OF A LIMITED SEISMIC STRENGTHENING OF AN EXISTING INDUSTRIAL BUILDING. THE SCOPE OF THE PROJECT IS LIMITED TO THE REQUIREMENTS OF CHAPTER A2 OF THE INTERNATIONAL EXISTING BUILDING CODE AT THE ROOF LEVEL ONLY INCLUDING WALL ANCHORAGE, CONTINUITY TIES, AND DRAGS.

THERE IS NO MEZZANINE

THE BUILDING CONSISTS OF A CONCRETE TILT-UP BUILDING WITH A PANELIZED ROOF CONSISTING OF A PLYWOOD DIAPHRAGM SUPPORTED ON 2X RAFTERS SUPPORTED ON 4X PURLINS THAT SPAN TO GLULAM BEAMS. ORIGINAL BUILDING AGE AND BUILDING CODE WAS NOT DETERMINED BUT IS REPORTED TO PRE-DATE THE MID-1970'S.

THERE IS CURRENTLY NO KNOWN JURISDICTIONAL MANDATE FOR SEISMIC STRENGTHENING FOR THIS BUILDING.

STORY DRIFT, DIAPHRAGM STRENGTH, WALL STRENGTHS, ETC. ARE OUT OF SCOPE AND NOT ADDRESSED.

3404.5 Voluntary seismic improvements. Alterations to existing structural elements or additions of new structural elements that are not otherwise required by this chapter and are initiated for the purpose of improving the performance of the seismic force-resisting system of an *existing structure* or the performance of seismic bracing or anchorage of existing nonstructural elements shall be permitted, provided that an engineering analysis is submitted demonstrating the following:

1. The altered structure and the altered nonstructural elements are no less in compliance with the provisions of this code with respect to earthquake design than they were prior to the *alteration*.
2. New structural elements are detailed and connected to the existing structural elements as required by Chapter 16.
3. New or relocated nonstructural elements are detailed and connected to existing or new structural elements as required by Chapter 16.
4. The alterations do not create a structural irregularity as defined in ASCE 7 or make an existing structural irregularity more severe.

JOB NAME: 1917 E St Andrew Place (Bldg F)	JOB NO: R-Voit-01F	SHEET NO: G - 2
	ENGINEER: MEO'	DATE: Oct '11
ANALYSIS: General		

Design Criteria

I. Code

- A. Chapter A2 of the 2009 International Existing Building Code

II. Lateral Loads

Wind - Not Applicable

III. Allowable Stresses for New Materials

A. Structural Masonry

Walls..... Not Applicable

B. Concrete

(E) Wall panels & Columns f'c = 2,500 psi at 28 Days Assumed
 (E) Slab on grade..... f'c = 2,000 psi at 28 Days Assumed

C. Reinforcing Steel

Slabs & Footings ASTM A615, Fy = 60 ksi
 Welded Bars ASTM A706, Fy = 60 ksi

D. Structural Steel

Structural Shapes (W, M, etc.) ASTM A992, Fy = 50 ksi
 Tubes ASTM A500, Fy = 46 ksi
 Miscellaneous ASTM A36, Fy = 36 ksi
 Pipe ASTM A53, Fy = 35 ksi

E. Timber

Sawn Lumber..... Douglas Fir Larch
 Glued Laminated Lumber..... Douglas Fir Larch

F. Soil

Based On Report By:

N/A

33.722733,-117.841008

from Internet

Conterminous 48 States
 2009 International Building Code
 Latitude = 33.722733
 Longitude = -117.84100800000002
 Spectral Response Accelerations Ss and S1
 Ss and S1 = Mapped Spectral Acceleration Values
 Site Class B - $F_a = 1.0$, $F_v = 1.0$
 Data are based on a 0.01 deg grid spacing

Period	S_a
(sec)	(g)
0.2	1.453 (Ss, Site Class B)
1.0	0.513 (S1, Site Class B)

Conterminous 48 States
 2009 International Building Code
 Latitude = 33.722733
 Longitude = -117.84100800000002
 Spectral Response Accelerations SMs and SM1
 $SMs = F_a \times Ss$ and $SM1 = F_v \times S1$
 Site Class D - $F_a = 1.0$, $F_v = 1.5$

Period	S_a
(sec)	(g)
0.2	1.453 (SMs, Site Class D)
1.0	0.770 (SM1, Site Class D)

Conterminous 48 States
 2009 International Building Code
 Latitude = 33.722733
 Longitude = -117.84100800000002
 Design Spectral Response Accelerations SDs and SD1
 $SDs = 2/3 \times SMs$ and $SD1 = 2/3 \times SM1$
 Site Class D - $F_a = 1.0$, $F_v = 1.5$

Period	S_a
(sec)	(g)
0.2	0.968 (SDs, Site Class D)
1.0	0.513 (SD1, Site Class D)

JOB NAME: 1917 E St Andrew Place (Bldg F)	JOB NO: R-Voit-01F	SHEET NO: L - 1
	ENGINEER: MEO'	DATE: Oct '11
ANALYSIS: Lateral		

Seismic Design Criteria

Per IBC 2009

Earthquake Loads per CBC 2010 & IBC 2009 Sections 1613 & ACSE 7-05 Sections 12-14

$E = \rho E_H + E_V$	$\rho = 1.00$	Redundancy Factor	ASCE 7 12.3.4
$E_M = \Omega_o \times E_H$	$\Omega_o = 2.00$	Overstrength Factor	ASCE 7 Table 12.2-1 (2.5 minus 0.5 for flex diaphragm per foot note "g") Shall not be less than 2.0
$E_V = 0.2 \times S_{DS} \times D$	$E_V = 0.19 D$	Vertical Component	ASCE 7 Section 12.4.2.2

Seismic Base Shear per CBC 2010 & IBC 2009 Sections 1613-1622

		Description	Reference
	$S_S = 1.453$	Spectral acceleration short period	IBC Map 1613.5(1)
	$S_1 = 0.513$	Spectral acceleration 1 sec period	IBC Map 1613.5(2)
	Soil Site Class = D	Soil Profile Type	from Geotech report
	calc'ed $F_a = 1.00$	Site coefficient, Site Class D	IBC Table 1613.5.3(1)
	calc'ed $F_V = 1.50$	Site coefficient, Site Class D	IBC Table 1613.5.3(2)
	$S_{MS} = F_a S_S = 1.45$	Short period max spectral response	
	$S_{M1} = F_V S_1 = 0.77$	1 sec period max spectral response	
	$S_{DS} = 2/3 S_{MS} = 0.97$	Design short period max spectral response	IBC EQ. 16-39
	$S_{D1} = 2/3 S_{M1} = 0.51$	Design 1 sec period max spectral response	IBC EQ. 16-40
Bldg height 22 ft	T = 0.20 sec	Fundamental Period of shearwall	ASCE 7 EQ. 12.8-7
	$T_o = 0.2 S_{D1} / S_{DS} = 0.11$ sec		
	$T_s = S_{D1} / S_{DS} = 0.53$ sec		
	S = 0.969	Design spectral response acceleration	ASCE 7 Table 12.8-1
	Seismic Use Group = II	Group II, typical	ASCE 7 Table 1-1
	Seismic Design Category = D	ASCE 7 TableS 11.6-1 and 11.6-2	
	I = 0.75	Importance Factor	IEBC A206.1
	Plan Structural Irregularities = None	None	
	Vertical Structural Irregularities = None	None	
Intermediate Precast Concrete Bearing Wall	R = 4.0	Response Modification Coefficient	ASCE 7 Table 12.2-1
	$C_d = 4.0$	Deflection Amplification Factor	ASCE 7 Table 12.2-1
Intermediate Precast Concrete Bearing Walls			
	$C_s = S_{DS} I / R = 0.182 W$	Building Base Shear	ASCE 7 EQ. 12.8-2
	$C_s \text{Max} = S_{D1} I / (R T) = 0.47 W$	Maximum Base Shear	ASCE 7 EQ. 12.8-3
	$C_s \text{Min} = 0.5 S_1 I / R = 0.05 W$	Minimum Base Shear ($S_1 > .6g$)	ASCE 7 EQ. 12.8-6
	Ft = 0.07 T V = 0.000 W	Concentrated Top Force	ASCE 7 EQ. 12.14-13
	V = 0.182 W + Ft	Governing Base Shear	Allowable = 0.130 W
		for flexible diaphragms	

Seismic Diaphragm Shear per CBC 2007 & IBC 2006 Section 1620.1.5

From above	0.182 W	Based on Lateral System	Governs
Minimum $F_p = 0.2 S_{DS} I$	0.145 W	Minimum	
$F_p = 0.4 S_{DS} I$	0.291 W	Max Diaphragm Accel	
	0.182 W	Governing Diaphragm acceleration	Allowable = 0.130 W

Seismic Load to Structural Elements per CBC 2010 & IBC 2009 Section 1620.2 (Wall Anchorage)


$FP = 0.8 S_{DS} I$	= 0.581 W	Category C & Higher	Allowable = 0.415 W
---------------------	------------------	---------------------	----------------------------

*Note - All seismic coefficients are ULTIMATE and must be divided by a factor of 1.4 for Allowable Stress Design.

JOB NAME: 1917 E St Andrew Place (Bldg F)	JOB NO: R-Voit-01F	SHEET NO: L- 2
	ENGINEER: MEO'	DATE: Oct '11
ANALYSIS: Lateral		

Tributary Mass for Wall Anchorage per Chapter A2 of IEBC

Purlins - Worst Case

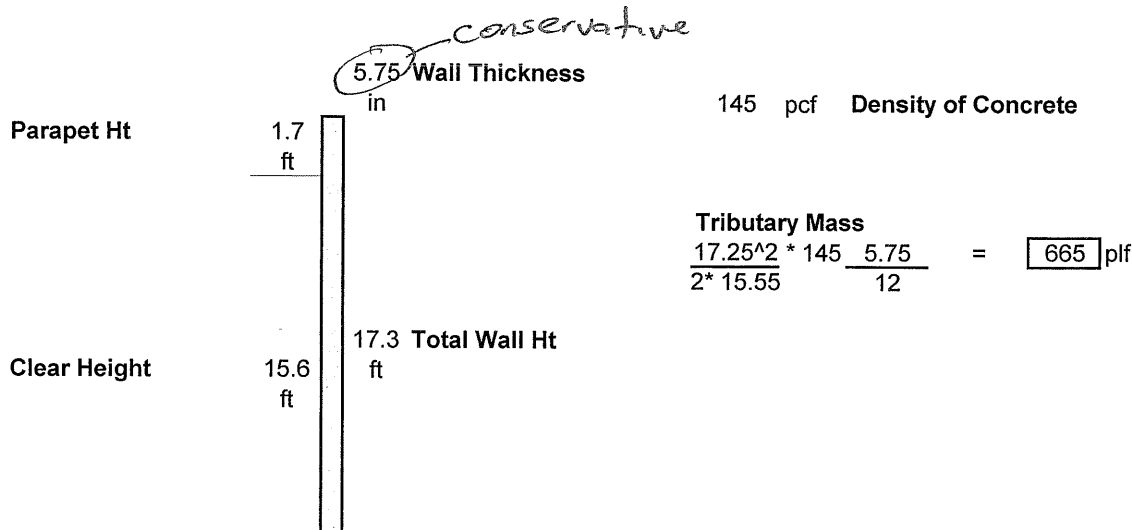

Wall Anchorage Force per 2010 CBC - Section 12.11 of ASCE 7-05

$F_p = 0.8 S_d s I W$
 $I = 0.75$ linked per A206.1
 $S_d s = 0.97$ linked
 $F_p = 0.8 S_d s I W = 0.58 W = 386 \text{ plf}$ Equation 12.11-1
 $0.1 W = 66 \text{ plf}$ Section 12.11.1
 $400 S_d s I = 291 \text{ plf}$ Section 12.11.2 b
 280 Section 12.11.2 c

Governs: $\boxed{386}$ plf Strength Level
 $\boxed{276}$ plf Allowable Level

Steel Elements - use **Allowable Stress Design** and apply a Load Factor of 1.0 per Section A206.2
Steel Demand $276 \text{ plf} \times 1.0 = \boxed{276} \text{ plf}$

Concrete Elements - use **Strength Design** and apply a Load Factor of 1.0 per Section A206.2
Concrete Demand $386 \text{ plf} \times 1.0 = \boxed{386} \text{ plf}$

Wood Elements - use **Allowable Stress Design** with no additional Load Factors per Section A206.2
Wood Demand $276 \text{ plf} \times 1.0 = \boxed{276} \text{ plf}$

	JOB NO: R-Voit-01F	SHEET NO: L- 3
JOB NAME: 1917 E St Andrew Place	ENGINEER: MEO'	DATE: Oct '11
ANALYSIS: Lateral		

Purlin Wall Anchorage & Continuity Ties

Purlins - Worst Case

Purlin Spacing:	8.0 ft				
Continuity Tie Spacing	24.0 ft				
Purlin Width	3.5 in	276 plf	2208 lbs	Steel Demand	Wood Type DF #1 (assumed)
Purlin Depth (Min)	13.25 in	386 plf	3091 lbs	Concrete Demand	per UBC 1982 (assumed)
Purlin Span	24.0 ft	276 plf	2208 lbs	Wood Demand	tension ft: 1200 psi
					flexural fb: 1400 psi

Epoxy Check

Demand 3091 lbs 8.0 ft - max spacing of **concrete** demand
 Capacity of Hilti HIT RE-500 SD based on PROFIS calculation for a **PAIR** of epoxy anchors
 Assumes 5.50 inch thick wall with 4.00 inch embedment with 0.625 inch diameter rod and
 8.0 inch spacing of anchors. Please see calc sheets
Capacity 4150 lbs **OK** **OK**

Zone 4 Hardware Check - Wall Anchor

Demand 2208 lbs 8.0 ft - max spacing of **steel** demand
 Capacity of Zone 4 Hardware from City of LA RR# 25334 for a pair of hardware Please see Zone 4 Table
 Assumes 3.50 inch thick member 13.25 inch deep member (min)
 Hardware **T2 43-5 (Pair)** Hardware **T2 24-6 (Pair)**
Capacity 5830 lbs **OK** Capacity 5071 lbs **OK** **OK**
 ICC ICC

Zone 4 Hardware Check - Continuity Tie

Demand 6623 lbs 24.0 ft - max spacing of **steel** demand
 Capacity of Zone 4 Hardware from City of LA RR# 25334 for a pair of hardware Please see Zone 4 Table
 Assumes 3.50 inch thick member 13.25 inch deep member (min)
 Hardware **T2 44-6 (Pair)** Hardware
Capacity ##### lbs **OK** Capacity lbs **OK** **OK**
 ICC

Subdiaphragm Check to Purlin Continuity Ties

Demand 4416 lbs 2 purlin bays of **wood** demand into subdiaphragm since next wall anchor is on CT line
 Assumes 24.0 ft deep subdiaphragm
 92 plf **Resulting Subdiaphragm Shear Demand**
 System **1/2" CDX plywood with 8d @ 6" oc** assumed - worst case
Capacity 270 lbs **OK** **OK**

Check Purlin Continuity Tie for Combined Gravity and Axial Seismic


Axial Wood Demand 6623 lbs 24.0 ft - max spacing of **wood** demand
 Resulting axial stress for 3.5 in. x 13.25 in. **142.8 psi**
 Assumed member DL **12.0 psf** resulting in uniform load **96 plf** for a span **24.0 ft**
 For a max moment c **82944 lb-in** on a section modulus **102.4 in^3**
 Resulting flexural stress for 3.5 in. x 13.25 in. **809.9 psi**
Unity Check axial bending

$$\frac{143}{1200} + \frac{809.9}{1400} = 0.70 < 1.6$$
 OK **OK**

JOB NO:	R-Voit-01F	SHEET NO:	L- 4
JOB NAME:	1917 E St Andrew Place (Bldg F)	ENGINEER:	MEO'
ANALYSIS:	Lateral	DATE:	Oct '11

Tributary Mass for Wall Anchorage per Chapter A2 of IEBC

Subpurlins - Worst Case

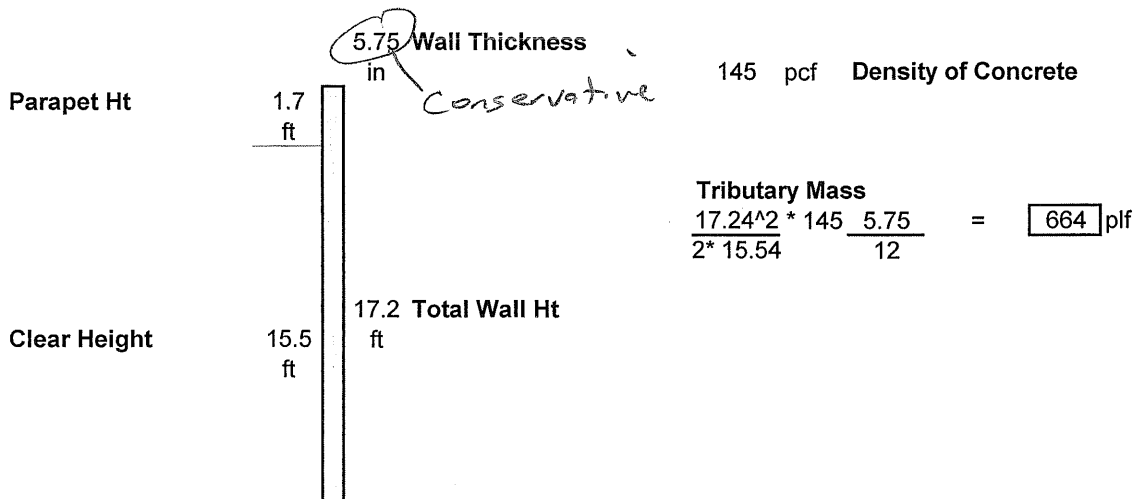

Wall Anchorage Force per 2010 CBC - Section 12.11 of ASCE 7-05

$F_p = 0.8 S_d s I W$
 $I = 0.75$ linked per A206.1
 $S_d s = 0.97$ linked
 $F_p = 0.8 S_d s I W = 0.58 W = 386$ plf Equation 12.11-1
 $0.1 W = 66$ plf Section 12.11.1
 $400 S_d s I = 291$ plf Section 12.11.2 b
 280 plf Section 12.11.2 c

Governs: 386 plf Strength Level
276 plf Allowable Level

Steel Elements - use **Allowable Stress Design** and apply a Load Factor of 1.0 per Section A206.2
Steel Demand $276 \text{ plf} \times 1.0 = \text{276}$ plf

Concrete Elements - use **Strength Design** and apply a Load Factor of 1.0 per Section A206.2
Concrete Demand $386 \text{ plf} \times 1.0 = \text{386}$ plf

Wood Elements - use **Allowable Stress Design** with no additional Load Factors per Section A206.2
Wood Demand $276 \text{ plf} \times 1.0 = \text{276}$ plf

	JOB NO: R-Voit-01F	SHEET NO: L- 5
JOB NAME: 1917 E St Andrew Place	ENGINEER: MEO'	DATE: Oct '11
ANALYSIS: Lateral		

Subpurlin (Rod) Wall Anchorage & Continuity Ties

Subpurlins - Worst Case

Anchor Line Trib:	6.0 ft	Loading per Anchor Line (based on spacing)		
Purlin Width	1.5 in	276 plf	1655 lbs	Steel Demand
Purlin Depth (Min)	3.5 in	386 plf	2317 lbs	Concrete Demand
Wood Type	DF #1 (assumed)	276 plf	1655 lbs	Wood Demand

Epoxy Check

Demand 2317 lbs **6.0** ft - max trib of *concrete* demand
Capacity of Hilti HIT RE-500 SD based on PROFIS calculation for a **SINGLE** epoxy anchor
Assumes 5.50 inch thick wall with 4.00 inch embedment with 0.625 inch diameter rod and
Capacity 2600 lbs **OK** Please see calc sheets

Development of Anchorage Force into Subdiaphragm - assumes field nailing

Demand 1655 lbs **1** # of rods of *wood* demand adjacent to analyzed rafter line
Assumes 16.0 ft deep subdiaphragm
52 plf **Resulting Subdiaphragm Shear Demand** (note: load split between two rafter lines)
System **1/2" CDX plywood with 8d @ 12" oc** assumed - worst case - **field nailing**
Capacity 135 lbs **OK**

Subdiaphragm Check to GLB Continuity Ties

Demand 6620 lbs **4** # of rods of *wood* demand since the GLB wall anchors are not in subdiaphragm
Assumes 16.0 ft deep subdiaphragm
207 plf **Resulting Subdiaphragm Shear Demand**
System **1/2" CDX plywood with 8d @ 6" oc** assumed - worst case
Capacity 270 lbs **OK**

Zone 4 Hardware Check - Continuity Tie on GLBs

Demand 7172 lbs **26.0** ft - max spacing of *steel* demand
Capacity of Zone 4 Hardware from City of LA RR# 25334 for a pair of hardware Please see Zone 4 Table
Assumes 5.125 inch thick member 11.25 inch deep member (min)
Hardware **T2 44-6 (Pair)** Hardware
Capacity **####** lbs **OK** Capacity lbs **OK**
ICC

Zone 4 - ICC report #5302

TABLE 2—CT CONTINUITY TIE AND T2 TENSION TIE/HOLD-DOWN TENSION DESIGN CAPACITIES FOR PAIRED CONNECTORS (Design Capacities are based upon Allowable Stress Design)

CT/T2 Paired Connection (PC) System					CT/T2 Paired Connection (PC) Design Capacities (pounds) ($C_D = 1.33$) ^{1,2,3,4,5,9,10,12}									
PC Model Quantity & CT/T2	A307 Bolts Quantity & Diam. (inches)	Min. End Distance ⁶ (inches)	Anchor Rods ^{7,11} ($C_D = 1.33$) A36 ($F_u = 58,000$ psi)		b ^a min. width (depth) (inches)	t (inches), length of bolt in wood member (thickness)								
			Diam. (inches)	Capacity (pounds)		1.50	2.50	3.00	3.50	5.125	5.50	7.50		
(2) 23-5	(2) 3/8	2 5/8	(2) 5/8	15630	3.5	2065	2662							
(2) 43-5	(4) 3/8				3.5	4190	5630							
(2) 63-5	(6) 3/8				3.5	6270	8746							
					5.5	6264								
(2) 68-5	(8) 3/8	3 1/2	(2) 3/4	22503	3.5	6270	8783	10559	11681					
(2) 24-8	(2) 1/2				5.5	1750	11651	11681						
(2) 44-8	(4) 1/2				7.25	6378								
					3.5	2783	4253	5071						
(2) 64-8	(6) 1/2	5 1/4	(2) 1	36998	3.5	5055	8424	10109	10305					
(2) 84-8	(8) 1/2				5.5	5888	9310	10385						
					3.5	5055	8424	10109	11794	14967	15548			
					5.5	7363	11272	14726	15548	15548				
(2) 84-8	(8) 1/2	1 3/8	(2) 3/4	22503	7.25	8378	13605	15548						
					3.5	5055	8424	10109	11794	14967	16082	20731		
					5.5	7983	12272	14726	17181	20731	20731			
					7.25	9206	15343	18411	20731					
(2) 28-8	(2) 5/8	1 3/8	(2) 3/4	22503	5.5	3491	5819	6983	7923					
(2) 48-8	(4) 5/8				5.5	6683	11638	13665	16196					
(2) 68-8	(6) 5/8				5.5	17177	11981	14359	16746	24294				
					7.25	9034	15059	18087	21078					
(2) 88-8	(8) 5/8	(2) 1	36998	36998	9.25	10474	17493	20948	24294					
					5.5	7177	11981	14353	16746	27600	32362	37362		
					7.25/7.5	8034	15059	18087	21078					
					9.25	10604	18007	21609	25210					
(2) 28-8	(2) 3/4	5 1/4	(2) 3/4	22503	5.5	4190	6683	8379	9776	11409				
(2) 48-8	(4) 3/4				5.5	6690	11650	13661	16311	23322				
					7.25	8379	13605	16758	19551					
					5.5	6560	11650	13661	16311	26380	34983	34983		
(2) 68-8	(6) 3/4	(2) 1 1/8	50807	50807	7.25/7.5	8562	14789	17723	20677	34983	34983			
					9.25	10847	17745	21294	24842					
					11.25	11979	19955	23848						
					13.25	12569	20948	26137	26327					

For SI: 1 inch = 25.4 mm, 1 pound = 4.45 N, 1 psi = 6.89 kPa

TABLE 2—CT CONTINUITY TIE AND T2 TENSION TIE/HOLD-DOWN TENSION DESIGN CAPACITIES FOR PAIRED CONNECTORS—(Continued)

CT/T2 Paired Connection (PC) System					CT/T2 Paired Connection (PC) Design Capacities (pounds) ($C_D = 1.33$) ^{1,2,3,4,5,9,10,12}								
PC Model Quantity & CT/T2	A307 Bolts Quantity & Diam. (inches)	Min. End Distance ⁶ (inches)	Anchor Rods ^{7,11} ($C_D = 1.33$) A36 ($F_u = 58,000$ psi)		b ^a min. width (depth) (inches)	t (inches), length of bolt in wood member (thickness)							
			Diam. (inches)	Capacity (pounds)		1.50	2.50	3.00	3.50	5.125	5.50	7.50	
(2) 27-8	(2) 7/8	6 1/8	(2) 1	36998	5.5	4938	8146	9776	11405	15529			
(2) 47-8	(4) 7/8				5.5	6804	11340	13603	15876	25657	27634	31744	
					7.25/7.5	8893	14482	17379	20275	31744	31744		
					9.25	9778	16283	19551	22810				
(2) 68-8	(2) 1	7	(2) 1 1/8	50807	5.5	5588	9310	11172	13034	19066	20282		
					5.5	6917	11029	13235	15441	24954	26780	36518	
(2) 48-8	(4) 1				7.25/7.5	8517	14186	17035	19874	34795	36850	41451	
					9.25/9.5	10331	17216	20683	24105	37670	40684		
(2) 68-10	(6) 1	(2) 1 1/4	62470	62470	11.25	11172	16620	22344	28038	38171			
					5.5	6917	11029	13235	15441	24954	26760	36518	
					7.25/7.5	8517	14186	17035	19874	34795	36850	52977	62192
					9.25/9.5	10331	17216	20683	24105	37670	41661		
		11.25/11.5	11688	16477	22373	27268	48972	51539					
		13.25/13.5	12563	20971	25165	28359	54953	60183					
		>15.5					NOT APPLICABLE						

For SI: 1 inch = 25.4 mm, 1 pound = 4.45 N, 1 psi = 6.89 kPa

- Design capacities have been increased by a 1.33 load duration factor (C_D) in accordance with Section 1612.3.3 of the UBC. Wood member design capacities include consideration of tensile stresses.
- Maximum bolt design capacities in the minimum size wood member are shown by ##
- Maximum bolt design capacities are achieved in smaller size wood members in areas shown by c
- Design capacities controlled by the net section tension capacity of the wood member are shown by ##
- Maximum design capacities of wood members are achieved with connectors using fewer and/or smaller bolts or both in areas shown by ##
- The minimum end distance, from the end of the wood member to the centerline of the first CT/T2 bolt, is seven (7) CT/T2 bolt diameters. End distance may be increased with no decrease in design capacities.
- The capacity of the concrete anchor must be equal to or greater than the design capacity of the connector being specified.
- b = width (depth) of the wood member.
- The design engineer shall check the wood member's design capacity for use conditions subject to additional loads (i.e. roof and floor dead loads). The applicable formulae and allowable stresses, per the 1991 NDS, should be used when calculating design capacities for wood members subject to a combination of bending about both axes and axial tension or compression.
- Table is based on wood type and grade, Douglas Fir-Larch, No. 2 typ., No. 1 @ 5 x 5 and larger.
- For anchor rod design capacities of ASTM A163-B7, A364-BD and A440 the A36 ($F_u = 58.0$ ksi) tension capacities shown in the tables should be multiplied by the following factors:

Anchor Rod (Diameter)	$F_{u min}$ (ksi)	Factor
ASTM A163-B7 (5/8 - 1 1/2)	125.0	2.155
ASTM A364-BD (5/8 - 1 1/2)	150.0	2.586
ASTM A440 (5/8 - 1)	120.0	2.069
ASTM A440 (1 1/8 - 1 1/2)	105.0	1.810

12 Design capacities are based upon allowable stress design.

5 of 21
ER-5302
Page 7 of 21
11

JOB NAME: 1917 E St Andrew Place (Bldg F)	JOB NO: R-Voit-01F	SHEET NO: L-7
	ENGINEER: MEO'	DATE: Oct '11
ANALYSIS: General		

Wall Angle Brackets at Purlins and GLBS

GLB Wall anchorage

FEMA & COLA require that the effects of the pilaster be considered.

Regular Trib = 4'

Trib w/ pilaster effect = assume double = 8'

↳ This would be 1/3 of panel Length (Conservative)

OK


Epoxy

based on previous calc, each anchor good for 4.0' of Trib
we will be providing a pair of anchors (each side)
so capacity is 8'

OK

Hardware

due to panel joint & other obstructions, provide angle kickers

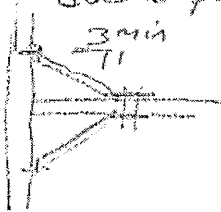

$$\text{Load } 8' \times 465 \text{ plf} = \frac{3720 \#}{2 \text{ braces}} = 1860 \#/\text{brace}$$

increase due to skew

$$\frac{3.16}{3}$$

$$1860 \times \frac{\sqrt{1^2 + 3^2}}{3} = 1960 \#$$

L3x3x 1/4 w/ 1960# tension/compression

per AISC 13th p.4-173 Table 4-11

capacity for 9' long 6.33k < 1.96k
E way!

OK

Hardware bolts

$$\frac{1860 \#}{2 \text{ bolts}} = 930 \# \text{ in } 5/8" \text{ GLB}$$

NDS p.90 Table 11I 5/8" stl, double shear, Z₁₁, DF, 5/8" ϕ

capacity 2440#

$$\frac{3720 \#}{2440 \#/\text{bolt}} = 1.5 \Rightarrow \underline{2 \text{ bolts}}$$

(2) 5/8" ϕ MB
reg'd


PROFIS Anchor 2.1.4


www.hilti.us

Company: National Engineering & Consulting
 Specifier: MEO'
 Address:
 Phone | Fax: - | -
 E-Mail:

Page: 1
 Project: 5.5" Thick Concrete
 Sub-Project | Pos. No.:
 Date: 7/6/2011

Specifier's comments:
Input data

Anchor type and diameter: HIT-RE 500-SD + HAS, 5/8
 Effective embedment depth: $h_{e,inst} = 4.000$ in. ($h_{e,inst} = 4.000$ in.)
 Material: ASTM F 568M Class 5.8
 Evaluation Service Report: ESR 2322
 Issued | Valid: 4/1/2010 | -
 Proof: design method ACI 318 / AC308
 Stand-off installation: $e_a = 0.000$ in. (no stand-off); $t = 0.500$ in.
 Anchor plate: $l_p \times l_p \times t = 20.000 \times 20.000 \times 0.500$ in. (Recommended plate thickness: not calculated)
 Profile: S shape (AISC); (L x W x T x FT) = 3.000 in. x 2.330 in. x 0.170 in. x 0.260 in.
 Base material: cracked concrete, 2500, $f'_c = 2500$ psi; $h = 5.500$ in., Temp. short/long: 70/70°F
 Installation: hammer drilled hole, installation condition: dry
 Reinforcement: tension: condition B, shear: condition B; no supplemental splitting reinforcement present
 edge reinforcement: > No. 4 bar
 Seismic loads (cat. C, D, E, or F): yes (D.3.3.5)

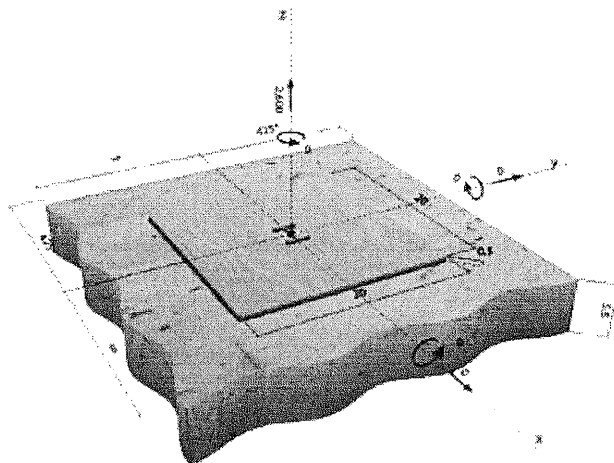Geometry [in.] & Loading [lb, in.-lb]

Proof | Utilization (Governing Cases)

Loading	Proof	Design values [lb]		Utilization [%]	Status
		Load	Capacity	β_u/β_v	
Tension	Bond Strength	2600	2601	100 / -	OK
Shear	-	-	-	- / -	-

Warnings

- Please consider all details and hints/warnings given in the detailed report!

Fastening meets the design criteria!

Input data and results must be checked for agreement with the existing conditions and for plausibility!

PROFIS Anchor (c) 2003-2009 Hilti AG, FL-9494 Schaan Hilti is a registered Trademark of Hilti AG, Schaan



www.hilti.us


PROFIS Anchor 2.1.4

Company: National Engineering & Consulting
 Specifier: MEO
 Address:
 Phone | Fax: - | -
 E-Mail:

Page: 1
 Project: 5.5" Thick Concrete
 Sub-Project | Pos. No.:
 Date: 7/8/2011

Specifier's comments:
Input data

Anchor type and diameter: HIT-RE 500-SD + HAS, 5/8
Effective embedment depth: $h_{e,act} = 3.719$ in. ($h_{e,nom} = 4.000$ in.)
Material: ASTM F 568M Class 5.8
Evaluation Service Report: ESR 2322
Issued | Valid: 4/1/2010 | -
Proof: design method ACI 318 / AC308
Stand-off installation: $e_s = 0.000$ in. (no stand-off); $t = 0.500$ in.
Anchor plate: $l_p \times l_p \times t = 4.000 \times 4.000 \times 0.500$ in. (Recommended plate thickness: not calculated)
Profile: S shape (AISC); (L x W x T x FT) = 3.000 in. x 2.330 in. x 0.170 in. x 0.260 in.
Base material: cracked concrete, 2500, $f'_c = 2500$ psi; $h = 5.500$ in., Temp. short/long: 70/70°F
Installation: hammer drilled hole, installation condition: dry
Reinforcement: tension: condition B, shear: condition B; no supplemental splitting reinforcement present
 edge reinforcement: > No. 4 bar
Seismic loads (cat. C, D, E, or F): yes (D.3.3.5)

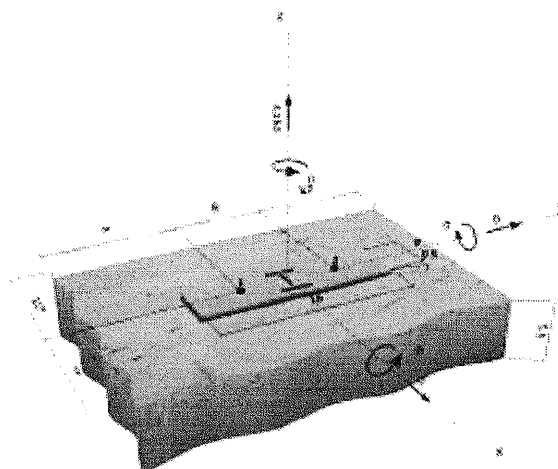Geometry [in.] & Loading [lb, in.-lb]

Proof | Utilization (Governing Cases)

Loading	Proof	Design values [lb]		Utilization [%]	Status
		Load	Capacity	R_u/β_u	
Tension	Bond Strength	4150	4152	100 / -	OK
Shear	-	-	-	- / -	-

Warnings

- Please consider all details and hints/warnings given in the detailed report!

Fastening meets the design criteria!

input data and results must be checked for agreement with the existing conditions and for plausibility!
 PROFIS Anchor (c) 2003-2009 Hilti AG, FL-9494 Schaan. Hilti is a registered Trademark of Hilti AG, Schaan.



www.hilti.us


PROFIS Anchor 2.1.4

Company: National Engineering & Consulting
 Specifier: MEO
 Address:
 Phone / Fax: - / -
 E-Mail:

Page: 1
 Project: 5.5" Thick Concrete
 Sub-Project / Pos. No.:
 Date: 7/6/2011

Specifier's comments:
Input data

Anchor type and diameter: HIT-RE 500-SD + HAS, 5/8
Effective embedment depth: $h_{w,act} = 3.768$ in. ($h_{w,calc} = 4.000$ in.)
Material: ASTM F 568M Class 5.8
Evaluation Service Report: ESR 2322
Issued / Valid: 4/1/2010 / -
Proof: design method ACI 318 / AC308
Stand-off installation: $e_s = 0.000$ in. (no stand-off); $t = 0.500$ in.
Anchor plate: $l_p \times l_y \times t = 4.000 \times 18.000 \times 0.500$ in. (Recommended plate thickness: not calculated)
Profile: S shape (AISC); (L x W x T x FT) = 3.000 in. x 2.330 in. x 0.170 in. x 0.260 in.
Base material: cracked concrete, 2500, $f'_c = 2500$ psi; $h = 5.500$ in., Temp. short/long: 70/70°F
Installation: hammer drilled hole, installation condition: dry
Reinforcement: tension: condition B, shear: condition B; no supplemental splitting reinforcement present
 edge reinforcement: > No. 4 bar
Seismic loads (cat. C, D, E, or F): yes (D.3.3.5)

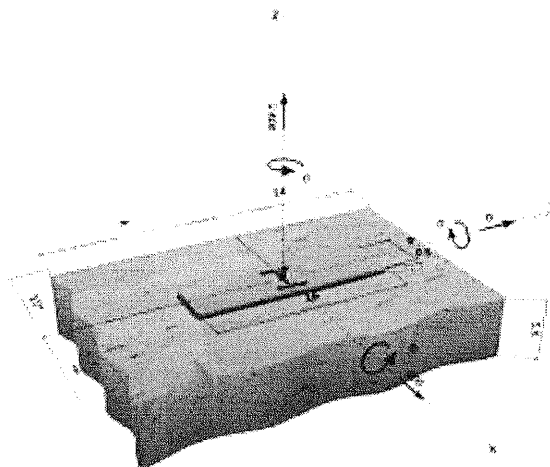Geometry [in.] & Loading [lb, in.-lb]

Proof / Utilization (Governing Cases)

Loading	Proof	Design values [lb]		Utilization [%]	Status
		Load	Capacity	P_u/P_n	
Tension	Bond Strength	2400	2448	98 / -	OK
Shear	Steel Strength (without lever arm)	900	4129	- / 22	OK
Loading	β_u	β_s	ζ	Utilization $\beta_{u,s}$ [%]	Status
Combined tension and shear loads	0.980	0.218	-	100	OK

Warnings

• Please consider all details and hints/warnings given in the detailed report!

Fastening meets the design criteria!

Input data and results must be checked for agreement with the existing conditions and for plausibility!
 PROFIS Anchor (c) 2003-2009 Hilti AG, FL-9494 Schaan. Hilti is a registered Trademark of Hilti AG, Schaan.



Planning & Building Agency
 Building Safety Division
 20 Civic Center Plaza
 P.O. Box 1988 (M-19)
 Santa Ana, CA 92702
 (714) 647-5800
 www.santa-ana.org

TENANT IMPROVEMENT PLAN CHECK COMMENTS

PLAN CHECK NO:	10173635,6,7		
PROJECT ADDRESS:	1831 S Ritchey St, 1917 E St. Andrews AND 1918 E Glenwood Pl.		
PLAN CHECK ENGINEER:	Kwak, Jason	TEL: 714	647-5866
		FAX: 714	647-5897
TYPE OF CONSTRUCTION:	V B		
OCCUPANCY CLASSIFICATION(S):	B, S-1		
PLAN CHECK DATES:		REMARKS/RECHECK ITEMS:	
APPLICATION	11/7/2011	_____	
INITIAL REVIEW	11/23/2011	_____	
EXPIRATION	5/5/2012	_____	
RECHECKS:	1. _____	PROJECT APPLICANT CONTACT PERSON:	
	2. _____	Michael Santillan	
	3. _____	TEL:	(949)716-9990
VALUATION:	\$30,000.00	FAX:	_____
FLOOD ZONE:	X-0602320277J	EMAIL:	michael.santillan@nationaleng.com

APPLICABLE CODE: 2010 CALIFORNIA BUILDING CODE (CBC) WITH CITY OF SANTA ANA AMENDMENTS

1. All items noted on this plan check report must be addressed. If you feel that an item is not applicable to your project, note "N/A" and discuss the reason with the plan checker.
2. Please indicate the sheet number and detail to the right of each correction, or note the number on the plans where the correction is made. Resubmit marked original, calculations and this correction sheet. A separate sheet for response may be used.
3. Resubmit 3 corrected sets of plans.
4. Meetings between the project applicant/designer and the plan reviewer shall be by appointment only. Please call (714) 647-5866 for an appointment.

5. The drawings/information submitted for Building Safety Division review is incomplete. The applicant shall, prior to resubmitting, complete all construction documents to show compliance with the 2010 California Building Standards Code with local amendments. – Provide required disabled accessible upgrade proposal with plans.
6. This review does not include mechanical, plumbing, fire sprinkler system, or electrical work. Separate plans, applications, fees, plan checks, and permits are required for mechanical, plumbing, fire sprinkler systems, and electrical work. Call 647-5800 for information. – If applicable.
7. **The applicant shall obtain clearances/approvals for the following prior to building permit issuance:**
 - Planning Division approval on the corrected/final set of drawings (647-5804.) Previously approved plans should be submitted to expedite the process.
 - Fire Department approval on the corrected/final sets of drawings (647-5839 or 647-5700)
 - Proof of Worker's Compensation Insurance shall be required at the time of permit issuance
8. **Show on the plans:**
 - Occupancy Classification(s)
 - Type of Construction
 - Fire Sprinkler System
9. It is the project designer's/property owner's responsibility to show compliance on the drawings with all applicable Federal and State Accessibility Standards.
10. **Drawings submitted to the Building Division for review shall provide the following information to insure compliance with CBC Section 1134B/Chapter 11B:**
 - An accessible entrance
 - An accessible route to the altered area
 - Accessible restrooms
 - Accessible telephone (if any)
 - Accessible drinking fountains, and
 - Parking, signage and alarms
11. Priority shall be given to those elements that will provide the greatest access in the above order.
12. Valuation of proposed project is calculated as \$_____. A minimum of 20% of valuation of construction is required to be spent towards providing disabled access in the priority order noted in the immediate previous item as noted in CBC Section 1134B. Revise the drawings to show compliance. Show both existing elements and how they will be upgraded to current standards.
13. Provide completed disabled accessible compliance form (attached) with each project.
14. Provide ICC or LA RR listing number on plans for Zone 4 hardware.



December 8, 2011

City of Santa Ana – Building & Safety Division

RE: 1917 E. St. Andrew Place
Plan Check # 10173636

Plan check responses:

Comment #5:

*The drawings/information submitted for Building Safety Division review is incomplete.....-
Provide required disable accessible upgrade proposal with plans.*

-Response: See sheet A-1, which shows proposed ADA upgrades

Comment #6:

This review does not include mechanical, plumbing, fire sprinkler system, or electrical work....

-Response: That is correct, there is no mechanical, plumbing, fire sprinkler system or electrical work proposed.

Comment #7:

The applicant shall obtain clearances/approvals....

-Response:

Comment #8:

Show on the plans:

- Occupancy Classification(s)
- Type of construction
- Fire Sprinkler System

-Response: information is now shown on sheet T-1.

Comment #9:

It is the project designer's/property owner's responsibility to show compliance on the drawings with all applicable Federal and State Accessibility Standards

-Response: Proposed ADA upgrades are now shown on the new sheet A-1

Comment #10:

Drawings submitted to the Building Division for review shall provide the following information to insure compliance with CBC Section 1134B/Chapter 11B:

- An accessible entrance

- An accessible route to the altered area
- Accessible restrooms
- Accessible telephone (if any)
- Accessible drinking fountains, and
- Parking, signage and alarms

-Response: see sheet A-1

Comment #11:

Priority shall be given to those elements that will provide the greatest access in the above order.

-Response: see sheet A-1

Comment #11:

Valuation of proposed project is calculated as \$30,000. A minimum of 20% of valuation of construction is required to be spent toward providing disable access....

-Response: see sheet A-1

Comment #13:

Provide completed disabled accessible compliance form (attached) with each project.

-Response: see the enclosed forms

Comment #14:

Provide ICC or LARR listing number on plans for Zone 4 hardware

Response: Complied. The LARR is 25334 and approved as of November 1, 2011. See structural plans detail 4/SD-1. As part of this approval, Zone4 revamped their product line and developed new capacities which I have attached.

- The old continuity tie T2-44-6 is now a T2-44-5 with greater capacity (Details 2 & 6/SD1).
- The old wall anchor T2-24-6 is now a T2-24-4 with greater capacity (Detail 4/SD1).

Since the Zone4 tension rod diameter is now smaller, the epoxy needs to be rechecked at the purlin wall anchors. The subpurlin and glulam wall anchorage were not changed. New calculations for the 1/2" dia epoxied wall anchor in the Zone4 hardware has been recalculated and attached.

Sincerely,

**Michael O'Brien, S.E.
National Engineering & Consulting, Inc.**

**Michael Santillan, Architect
National Engineering & Consulting, Inc.
27 Orchard
Lake Forest, CA 92630**

(714) 803-8454



plan check #1

Structural Calculations
Roof Seismic Strengthening - Partial
Concrete Tilt-up Building
1917 E St Andrew Place (Bldg F)
Santa Ana, CA

R-Voit-01F



Revision



December 5, 2011

27 Orchard, Suite 200
Lake Forest, CA 92630

Phone: (949) 716-9990 Fax: (949) 716-9997

www.national-eng.com

The structural calculations contained in this report relate only to the structure and site for which they were prepared. Referenced building codes, site-specific parameters for wind and seismic design, and any cited material/component design standards are current only for the governmental agency with jurisdiction over the design and construction of the proposed structure at the time the report was published. Some information utilized in the structural calculations may have been received from outside sources such as third party site development coordinators, geotechnical engineering reports, pre-engineered component manufacturers, or engineering/trade organizations. NEC is not responsible for the accuracy and/or changes to any information utilized herein as provided by outside sources.

TABLE B - COLA Chapter 91 & 96 CT or T2 PAIRED CONNECTION ASD CAPACITIES^{1,2,3,4,5,6,7,8}
DF-L No. 2 Grade typ., No. 1 @ 5x5 & larger

CT Metal ² 2 reqd	A36 Anchor Rod Diam. 2 reqd (1/8" increments) ⁴	A307 Bolts Quantity & Diameter (in)	b min. width of attached member (depth) reqd (in)	CT Paired Connection ASD Design Capacities (pounds)								Δ_s @ max. strength capacity ⁷	Δ_{ASD} @ max. allow. capacity ⁷	
				min. t (in), length of bolt in wood members each side of CT (thickness)										
				1.5	2.5	3	3.5	5.125	5.5	7.25/7.50				
CT or T2-43	4	(4) 3/8	3.5	5,010	6,260 ⁵	6,260 ⁵	6,260 ⁵	6,260 ⁵	6,260 ⁵	6,260 ⁵	6,260 ⁵	0.169	0.120	
CT or T2-24	4	(2) 1/2		3,360	5,600	6,235	6,235	6,235	6,235	6,235	6,235	0.229	0.164	
CT or T2-44	5	(4) 1/2		6,637	11,118	11,606 ⁵	11,606 ⁵	11,606 ⁵	11,606 ⁵	11,606 ⁵	11,606 ⁵	11,606 ⁵	0.194	0.139
CT or T2-64	6	(6) 1/2	5.5	[7,138]	[11,897]	[14,276]	15,577 ⁵	15,577 ⁵	15,577 ⁵	15,577 ⁵	15,577 ⁵	15,577 ⁵	0.173	0.124
			3.5	[7,138]	[11,897]	[14,276]	[16,658]	17,358 ⁵	17,358 ⁵	17,358 ⁵	17,358 ⁵	17,358 ⁵		
CT or T2-84	7	(8) 1/2	5.5	[10,662]	17,358 ⁵	17,358 ⁵	17,358 ⁵	17,358 ⁵	17,358 ⁵	17,358 ⁵	17,358 ⁵	17,358 ⁵	0.153	0.110
			7.25/7.5	12,377	17,358 ⁵	17,358 ⁵	17,358 ⁵	17,358 ⁵	17,358 ⁵	17,358 ⁵	17,358 ⁵	17,358 ⁵		
CT or T2-46	8	(4) 3/4	5.5	9,749	10,315 ⁵	10,315 ⁵	10,315 ⁵	10,315 ⁵	10,315 ⁵	10,315 ⁵	10,315 ⁵	10,315 ⁵	0.133	0.095
			5.5	[9,345]	[10,576]	[10,601]	[21,606]	[30,020]	30,249 ⁵	30,249 ⁵	30,249 ⁵	30,249 ⁵		
CT or T2-48	9	(4) 1	7.25/7.5	[12,029]	[20,048]	[24,057]	[28,067]	30,249 ⁵	30,249 ⁵	30,249 ⁵	30,249 ⁵	30,249 ⁵	0.142	0.101
			9.25/9.5	12,591	21,513	25,939	30,249 ⁵	30,249 ⁵	30,249 ⁵	30,249 ⁵	30,249 ⁵			
			5.5	[9,345]	[10,576]	[18,691]	[21,606]	[30,020]	30,474 ⁵	30,474 ⁵	30,474 ⁵	30,474 ⁵		
CT or T2-68	11	(6) 1	7.25/7.5	[12,029]	[20,048]	[24,057]	[28,067]	30,474 ⁵	30,474 ⁵	30,474 ⁵	30,474 ⁵	30,474 ⁵	0.126	0.090
			9.25/9.5	[14,590]	[24,317]	[29,180]	30,474 ⁵	30,474 ⁵	30,474 ⁵	30,474 ⁵	30,474 ⁵			
			11.25/11.5	[16,504]	[27,506]	30,474 ⁵	30,474 ⁵	30,474 ⁵	30,474 ⁵	30,474 ⁵	30,474 ⁵			
			13.25/13.5	18,622	29,662	30,474 ⁵	30,474 ⁵	30,474 ⁵	30,474 ⁵	30,474 ⁵	30,474 ⁵			
			5.5	[9,345]	[10,576]	[18,691]	[21,606]	[30,020]	30,474 ⁵	30,474 ⁵	30,474 ⁵	30,474 ⁵		

or SE 1 inch (in) = 25.4 mm, 1 pound = 4.45 N

Wood design capacities have been increased by a 1.60 load duration factor (C_D).

CT #x-y

CT = paired continuity tie
 a = number of bolts

b = diameter of bolts (in 1/8 inch increments)

y = diameter of All-thread/Anchor Rod specified by designer (in 1/8 inch increments)

Design capacity controlled by the net cross-section tension capacity of the wood member at bolts are shown by [##]

The capacity of the concrete anchor must be equal to or greater than the design capacity of the connector being specified.

The minimum end distance, from the end of the wood member to the centerline of the first CT bolt, is seven (7) CT bolt diameters. End distance may be increased with no decrease in design capacities.

Values are controlled by device capacity @ 1/8" deflection, as tested in a steel jig, divided by 5

Deflections at loads less than maximum P_B or P_{ASD} may be determined by multiplying by the ratio of the lesser load to the maximum load. Strength loads are the P_{ASD} shown times 1.4. Tabulated displacement consists of deformation and rotation of the hold-down (tie-down), and fastener slip of (bolt rotation) used to attach the hold-down (tie-down) to the wood member. Shrinkage of supporting wood members and anchor bolt/rod elongation shall be the responsibility of the Engineer of Record.

The user should note that hold-downs used in series shall account for the cumulative deformation of all hold-downs (tie-downs) within said series.

The assembly must have an allowable strength equal to or greater than the required strength of the assembly under the action of the ASD load combinations referenced in the applicable code.

Wall tie T2-24-4	New 6235#	old 5071#	T2-24-6	OK
Cont tie T2-44-5	11,606	10365	T2-44-6	OK

Epoxy Anchorage Design

In accordance with Section 1908.1.9 of the 2010 CBC, the epoxy anchorage to the wall need only be designed for the applied design force without consideration of the usual requirement for either a ductile (steel) failure or an Omega overstrength factor.

Therefore, the Seismic loads switch for seismic design categories C, D, E & F can be turned off (set to "no") on the Hilti Profis design. Seismic loads (cat. C, D, E, or F): no

1908.1.9 ACI 318, Section D.3.3. Modify ACI 318, Sections D.3.3.4 and D.3.3.5 to read as follows:

D.3.3.4 — Anchors shall be designed to be governed by the steel strength of a ductile steel element as determined in accordance with D.5.1 and D.6.1, unless either D.3.3.5 or D.3.3.6 is satisfied.

Exceptions:

1. *Anchors in concrete designed to support non-structural components in accordance with ASCE 7 Section 13.4.2 need not satisfy Section D.3.3.4.*
2. *Anchors designed to resist wall out-of-plane forces with design strengths equal to or greater than the force determined in accordance with ASCE 7 Equation 12.11-1 or 12.14-10 need not satisfy Section D.3.3.4.*



PROFIS Anchor 2.2.3

rw.hilti.us

Company: National Engineering & Consulting
 Specifier: NAL
 Address: -|-
 Phone / Fax: -|-
 E-Mail: -|-


Page: 1
 Project: 5.5" Thick conc 2.5-in r
 Sub-Project / Pos. No.:
 Date: 12/5/2011

Specifier's comments:

Input data

Anchor type and diameter: HIT-RE 500-SD + HAS, 1/2
 Effective embedment depth: $h_{\text{eff}} = 3.75$ in. ($h_{\text{min}} = -$ in.) *3.75" embed required > OK*
 Material: ASTM F 568M Class 5 B
 Evaluation Service Report: ESR 2322
 Issued / Valid: 4/1/2010 [-]
 Proof: design method ACI 318 / AC308
 Stand-off installation: $e_n = 0.000$ in. (no stand-off); $t = 0.500$ in.
 Anchor plate: $l_p \times l_t \times t = 3.000 \times 9.000 \times 0.500$ in. (Recommended plate thickness: not calculated)
 Profile: S shape (AISC); $(L \times W \times T \times FT) = 3.000$ in. \times 2.330 in. \times 0.170 in. \times 0.260 in.
 Base material: cracked concrete, 2500, $f'_c = 2500$ psi; $h = 5.500$ in., Temp. short/long: 70/70°F
 Installation: hammer drilled hole, installation condition: dry
 Reinforcement: tension: condition B, shear: condition B; no supplemental splitting reinforcement present
 edge reinforcement: none or < No. 4 bar
 Seismic loads (cat. C, D, E, or F): no

Geometry [in.] & Loading [lb, in.-lb]

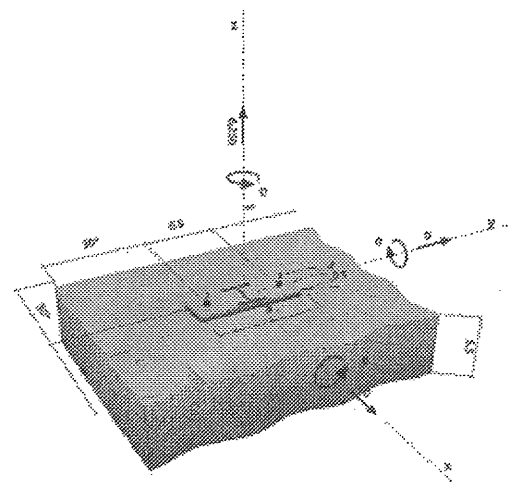

Proof / Utilization (Governing Cases)

Loading	Proof	Design values [lb]		Utilization [%]	Status
		Load	Capacity	β_u/β_r	
Tension	Concrete Breakout Strength	6250	6330	99 / -	OK
Shear	-	-	-	+	-

Warnings

Please consider all details and hints/warnings given in the detailed report!

*demand per L-3
 3091 # OK*

Fastening meets the design criteria!



Plan Check #1

Structural Calculations
Roof Seismic Strengthening - Partial
Concrete Tilt-up Building
1917 E St Andrew Place (Bldg F)
Santa Ana, CA

R-Voit-01F



Revision



December 5, 2011

27 Orchard, Suite 200
Lake Forest, CA 92630
Phone: (949) 716-9990 Fax: (949) 716-9997
www.national-eng.com

The structural calculations contained in this report relate only to the structure and site for which they were prepared. Referenced building codes, site-specific parameters for wind and seismic design, and any cited material/component design standards are current only for the governmental agency with jurisdiction over the design and construction of the proposed structure at the time the report was published. Some information utilized in the structural calculations may have been received from outside sources such as third party site development coordinators, geotechnical engineering reports, pre-engineered component manufacturers, or engineering/trade organizations. NEC is not responsible for the accuracy and/or changes to any information utilized herein as provided by outside sources.

TABLE B - COLA Chapter 91 & 96 CT or T2 PAIRED CONNECTION ASD CAPACITIES^{1,2,3,4,5,6,7,8}
DF-L No. 2 Grade typ., No. 1 @ 5x5 & larger

CT Model ² 2 reqd	A307 Anchor Rod Diam, 2 reqd (1/8" increments) ⁴	A307 Bolts Quantity & Diameter (in)	b min. width of attached member (depth) reqd (in)	CT Paired Connection ASD Design Capacities (pounds)							Δ_{ct} @ max. strength capacity ⁷	Δ_{asd} @ max. allow. capacity ⁷	
				min. t (in), length of bolt in wood members each side of CT (thickness)									
				1.5	2.5	3	3.5	5.125	5.5	7.25/7.50			
CT or T2-43	4	(4) 3/8	3.5	5,010	6,260 ⁵	6,260 ⁵	6,260 ⁵	6,260 ⁵	6,260 ⁵	6,260 ⁵	0.169	0.120	
CT or T2-24	4	(2) 1/2		3,360	5,600	6,235	6,235	6,235	6,235	6,235	0.229	0.164	
CT or T2-44	5	(4) 1/2		6,637	11,118	11,606 ⁵	11,606 ⁵	11,606 ⁵	11,606 ⁵	11,606 ⁵	11,606 ⁵	0.194	0.139
CT or T2-64	6	(6) 1/2		[7,138]	[11,897]	[14,276]	15,577 ⁵	15,577 ⁵	15,577 ⁵	15,577 ⁵	15,577 ⁵	0.173	0.124
CT or T2-84	7	(8) 1/2	5.5	9,679	15,577 ⁵	15,577 ⁵	15,577 ⁵	15,577 ⁵	15,577 ⁵	15,577 ⁵	0.153	0.110	
			3.5	[7,138]	[11,897]	[14,276]	[16,656]	17,358 ⁵	17,358 ⁵	17,358 ⁵			
			5.5	[10,862]	17,358 ⁵	17,358 ⁵	17,358 ⁵	17,358 ⁵	17,358 ⁵	17,358 ⁵			
CT or T2-45	8	(4) 3/4	5.5	9,749	10,315 ⁵	10,315 ⁵	10,315 ⁵	10,315 ⁵	10,315 ⁵	10,315 ⁵	0.133	0.095	
			7.25/7.5	12,377	17,358 ⁵	17,358 ⁵	17,358 ⁵	17,358 ⁵	17,358 ⁵	17,358 ⁵			
			5.5	[9,345]	[10,376]	[16,691]	[21,606]	[30,020]	30,249 ⁵	30,249 ⁵			
CT or T2-48	9	(4) 1	5.5	[9,345]	[10,376]	[16,691]	[21,606]	[30,020]	30,249 ⁵	30,249 ⁵	0.142	0.101	
			7.25/7.5	[12,029]	[20,048]	[24,057]	[28,067]	30,249 ⁵	30,249 ⁵	30,249 ⁵			
			9.25/9.5	12,591	21,513	25,939	30,249 ⁵	30,249 ⁵	30,249 ⁵	30,249 ⁵			
CT or T2-68	11	(6) 1	5.5	[9,345]	[10,376]	[16,691]	[21,606]	[30,020]	30,474 ⁵	30,474 ⁵	0.126	0.090	
			7.25/7.5	[12,029]	[20,048]	[24,057]	[28,067]	30,474 ⁵	30,474 ⁵	30,474 ⁵			
			9.25/9.5	[14,590]	[24,317]	[29,180]	30,474 ⁵	30,474 ⁵	30,474 ⁵	30,474 ⁵			
			11.25/11.5	[16,504]	[27,506]	30,474 ⁵	30,474 ⁵	30,474 ⁵	30,474 ⁵	30,474 ⁵			
			13.25/13.5	16,622	29,662	30,474 ⁵	30,474 ⁵	30,474 ⁵	30,474 ⁵	30,474 ⁵			

or SE 1 inch (in) = 25.4 mm, 1 pound = 4.45 N

Wood design capacities have been increased by a 1.60 load duration factor (C_D).

CT #y

CT = paired continuity tie
 a = number of bolts

b = diameter of bolts (in 1/8 inch increments)
 y = diameter of All-thread/Anchor Rod specified by designer (in 1/8 inch increments)

Design capacity controlled by the net cross-section tension capacity of the wood member at bolts are shown by [##]

The capacity of the concrete anchor must be equal to or greater than the design capacity of the connector being specified.

The minimum end distance, from the end of the wood member to the centerline of the first CT bolt, is seven (7) CT bolt diameters. End distance may be increased with no decrease in design capacities.

Values are controlled by device capacity @ 1/8" deflection, as tested in a steel jig, divided by 5

Deflections at loads less than maximum P_B or P_{ASD} may be determined by multiplying by the ratio of the lesser load to the maximum load. Strength loads are the P_{ASD} shown lines 1.4. Tabulated displacement consists of deformation and rotation of the hold-down (tie-down), and fastener slip of (bolt rotation) used to attach the hold-down (tie-down) to the wood member. Shrinkage of supporting wood members and anchor bolt/rod elongation shall be the responsibility of the Engineer of Record.

The user should note that hold-downs used in series shall account for the cumulative deformation of all hold-downs (tie-downs) within said series.

The assembly must have an allowable strength equal to or greater than the required strength of the assembly under the action of the ASD load combinations referenced in the applicable code.

Well tricha T2-24-4	New 6235#	old 5071#	T2-24-6	OK
Cont tie T2-44-5	11,606	10365	T2-44-6	OK

Epoxy Anchorage Design

In accordance with Section 1908.1.9 of the 2010 CBC, the epoxy anchorage to the wall need only be designed for the applied design force without consideration of the usual requirement for either a ductile (steel) failure or an Omega overstrength factor.

Therefore, the Seismic loads switch for seismic design categories C, D, E & F can be turned off (set to "no") on the Hilti Profis design. Seismic loads (cat. C, D, E, or F): no

1908.1.9 ACI 318, Section D.3.3. Modify ACI 318, Sections D.3.3.4 and D.3.3.5 to read as follows:

D.3.3.4 – Anchors shall be designed to be governed by the steel strength of a ductile steel element as determined in accordance with D.5.1 and D.6.1, unless either D.3.3.5 or D.3.3.6 is satisfied.

Exceptions:

- 1. Anchors in concrete designed to support non-structural components in accordance with ASCE 7 Section 13.4.2 need not satisfy Section D.3.3.4.*
- 2. Anchors designed to resist wall out-of-plane forces with design strengths equal to or greater than the force determined in accordance with ASCE 7 Equation 12.11-1 or 12.14-10 need not satisfy Section D.3.3.4.*

L-9 (1)



PROFIS Anchor 2.2.3

www.hilti.us


Company:	National Engineering & Consulting	Page:	1
Specifier:	NAL	Project:	5.5" Thick conc 2-5-in r
Address:		Sub-Project / Pos. No.:	
Phone / Fax:	- / -	Date:	12/5/2011
E-Mail:			

Specifier's comments:

Input data

Anchor type and diameter:	HIT-RE 500-SD + HAS, 1/2"	<i>3.75" embed required > OK</i>
Effective embedment depth:	<i>h_{ef} = 3.750 in (h_{min} = - in.)</i>	
Material:	ASTM F 568M Class 5.8	<i>4" embed used</i>
Evaluation Service Report:	ESR 2322	
Issued / Valid:	4/1/2010 / -	
Proof:	design method ACI 318 / AC308	
Stand-off installation:	e _s = 0.000 in. (no stand-off); t = 0.500 in.	
Anchor plate:	l ₁ x l ₂ x t = 3.000 x 9.000 x 0.500 in. (Recommended plate thickness: not calculated)	
Profile:	S shape (AISC); (L x W x T x FT) = 3.000 in. x 2.330 in. x 0.170 in. x 0.260 in.	
Base material:	cracked concrete, f' _c = 2500 psi; h = 5.500 in., Temp. short/long: 70/70°F	
Installation:	hammer drilled hole, installation condition: dry	
Reinforcement:	tension: condition B, shear: condition B; no supplemental splitting reinforcement present	
Seismic loads (cat. C, D, E, or F):	edge reinforcement: none or < No. 4 bar	
	no	

Geometry [in.] & Loading [lb, in.-lb]

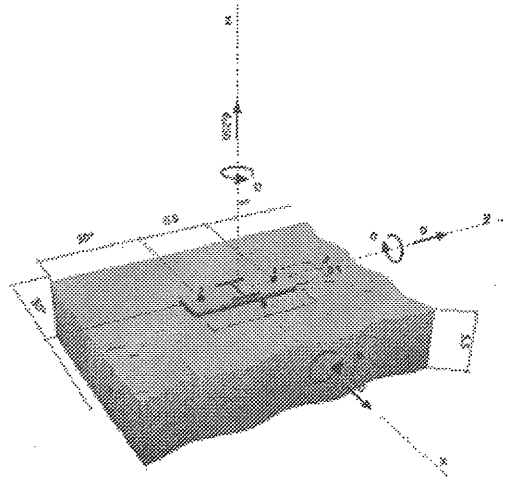

Proof / Utilization (Governing Cases)

Loading	Proof	Design values [lb]		Utilization [%]	Status
		Load	Capacity	R _d /R _n	
Tension	Concrete Breakout Strength	6250	<u>6330</u>	99%	OK
Shear	-	-	-	-	-

*demand per L-3
3091 # OK*

Warnings

Please consider all details and hints/warnings given in the detailed report!

Fastening meets the design criteria!

Input data and results must be checked for agreement with the existing conditions and for plausibility!
PROFIS Anchor (c) 2003-2009 Hilti AG, FL-6494 Schaan. Hilti is a registered trademark of Hilti AG, Schaan.

VOLUNTARY SEISMIC STRENGTHENING

AN INDUSTRIAL BLDG. RETROFIT

1917 ST. ANDREW PL. BLDG. F

SANTA ANA CA. 92705

NATIONAL
ENGINEERING & CONSULTING, INC.

27 ORCHARD
LAKE FOREST, CA. 92650
PHONE: (949) 716-9997
FAX: (949) 716-9997

PROJECT TEAM:

OWNER:

OWNER: ROB SOCCI
ADDRESS: 3500 W. ORANGEWOOD AVE.
CITY, STATE ZIP: ORANGE, CA 92868
PHONE: (714) 935-2314

APPLICANT:

NAME: NATIONAL ENGINEERING & CONSULTING, INC.
ADDRESS: 27 ORCHARD
CITY, STATE ZIP: LAKE FOREST, CA 92630-8304
PHONE: (949) 766-9990 X. 510
FAX: (949) 716-9997
CONTACT: MIKE O'BRIEN
E-MAIL: mike.obrien@nationaleng.com

STRUCTURAL ENGINEER:

NAME: NATIONAL ENGINEERING & CONSULTING, INC.
ADDRESS: 27 ORCHARD
CITY, STATE ZIP: LAKE FOREST, CA 92630-8304
PHONE: (949) 766-9990 X. 570
FAX: (949) 716-9997
CONTACT: MIKE O'BRIEN
E-MAIL: mike.obrien@nationaleng.com

PROJECT DESCRIPTION:

THE BUILDING CONSISTS OF A CONCRETE TILT-UP BUILDING WITH A PANELIZED WOOD ROOF DIAPHRAGM. THE PROJECT CONSISTS OF A VOLUNTARY PARTIAL SEISMIC REHABILITATION OF AN EXISTING INDUSTRIAL BUILDING. THE SCOPE OF THE PROJECT IS LIMITED TO WALL ANCHORAGE AND CONTINUITY TIES.

THE PARTIAL SEISMIC REHABILITATION IS BEING PERFORMED ON A VOLUNTARY BASIS DUE TO OWNER'S REQUEST. THERE IS CURRENTLY NO MANDATE FOR SEISMIC STRENGTHENING FROM THE CITY OF SANTA ANA FOR THIS PROPERTY. THE DESIGN OF THE REHABILITATION IS BASED ON THE REQUIREMENTS OF INTERNATIONAL EXISTING BUILDING CODE CHAPTER A2.

ALSO, WORK INCLUDES MINOR ADA UPGRADES:

1. ADD ONE NEW HC PARKING SPACE
2. REPLACE A NON-COMPLIANT DRINKING FOUNTAIN W/ NEW COMPLIANT FOUNTAIN.
3. LOWER EXISTING PAPER TOWEL DISPENSER TO 'ACCESSIBLE' HEIGHT.

CODE COMPLIANCE:

ALL WORK AND MATERIALS SHALL BE PERFORMED AND INSTALLED IN ACCORDANCE WITH THE CURRENT EDITIONS OF THE FOLLOWING CODES AS ADOPTED BY THE LOCAL GOVERNING AUTHORITIES. NOTHING IN THESE PLANS IS TO BE CONSTRUED TO PERMIT WORK NOT CONFORMING TO THE LATEST EDITIONS OF THE FOLLOWING CODES.

1. 2010 CALIFORNIA ADMINISTRATIVE CODE.
2. 2010 CALIFORNIA BUILDING CODE (CBC).
3. 2010 CALIFORNIA ELECTRICAL CODE (CEC).
4. 2010 CALIFORNIA ENERGY CODE.
5. 2010 CALIFORNIA MECHANICAL CODE (CMC).
6. 2010 CALIFORNIA PLUMBING CODE (CPC).
7. ANSI/TIA-222-G LIFE SAFETY CODE NFPA-101
8. LOCAL BUILDING CODE
9. CITY/COUNTY ORDINANCES

PROJECT INFORMATION:

PROPERTY INFORMATION:

JURISDICTION: CITY OF SANTA ANA
BUILDING AREA: 31,537.44 FT.
LOT AREA: 15,841 FT.
CURRENT ZONING: (UNCHANGED)
CONSTRUCTION TYPE: V-B (UNCHANGED)
SPRINKLERS?: NO
OCCUPANCY GROUP: B, S-1
NO. OF STORIES: 1 (UNCHANGED)
HEIGHT: 19'± (UNCHANGED)
PLAN CHECK NUMBER: -

APPROVED
PLANNING DIVISION

MASTER ID: 2011-99981
G.P. IND Zone M1
PLANNER: B. Apple DATE: 11-7-11
TRANSFERRED BY: mi DATE: 1-3-12
PLANNING INSPECTION REQUIRED: ROUGH: NONE FINAL: X
NAME: (714)
RETAIN PLANS FOR FUTURE REVISIONS. SUBJECT TO ITEMS CHECKED AND CONDITIONS BELOW:
 INTERIOR ONLY
 NO EXTERIOR ALTERATIONS/MODIFICATIONS
 ALL MATERIALS TO MATCH EXISTING
 CONTAINING PEG-BOARD
 SUBMIT LANDSCAPE PLANS

Subject To The Following Approvals:

- Planning Department
- Fire Department
- Police Department
- Public Works Agency
- Grading Permit
- County of Orange Health Department
- Cal / OSHA
- Flood Plain
- School District
- Park Acquisition and Development

PERMIT TYPE: BLDG/ELECT/PLB
MECH GRADING
PERMIT#: 10173636
OCC. GROUP: B/S1
CONSTR. TYPE: V-B Non-F.S.
CODE EDITION: 2010 CBC
FLOOD ZONE: X
FLOOD ZONE CERTIF. REQ'D: YES (NO)
MICROFILM: YES (NO)
RADIANT BARRIER @ ROOF: YES (NO)
RESIDENTIAL DEV. FEE: YES (NO)
SCHOOL DISTRICT: YES (NO)

RECEIVED
DEC 06 2011
City of Santa Ana

12-15-11
FIRE DEPARTMENT PLAN REVIEW COMPLETED - NO INSPECTION REQUIRED


STRUCTURAL CONSTRUCTION

USE REQUIRED PER...
AND SPECIFICATIONS SHALL BE...
SANTA ANA

SANTA ANA

SHEET INDEX:


	DESCRIPTION:
T-1	TITLE SHEET
T-2	ALTA SURVEY (FOR REFERENCE ONLY)
A-1	ADA UPGRADES
SN-1	GENERAL NOTES & SPECIFICATIONS
S-1	ROOF FRAMING PLAN
SD-1	DETAILS

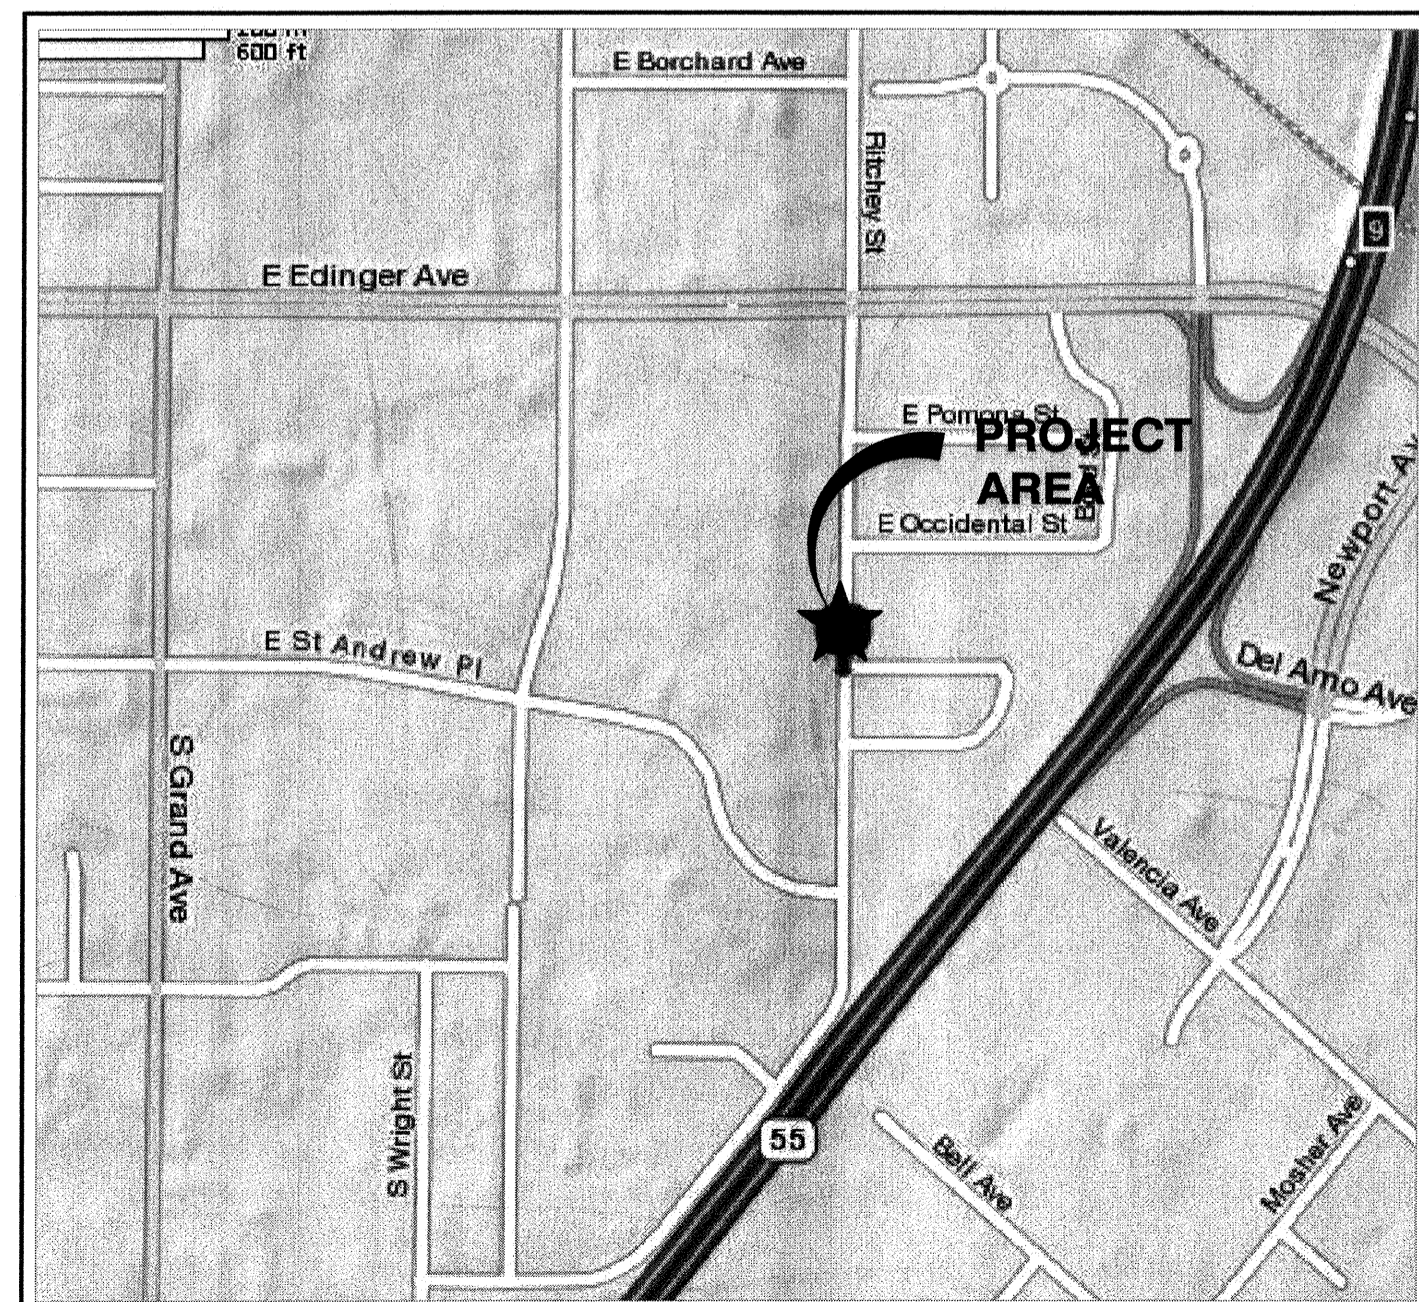

VICINITY MAP
NTS



AREA OF WORK

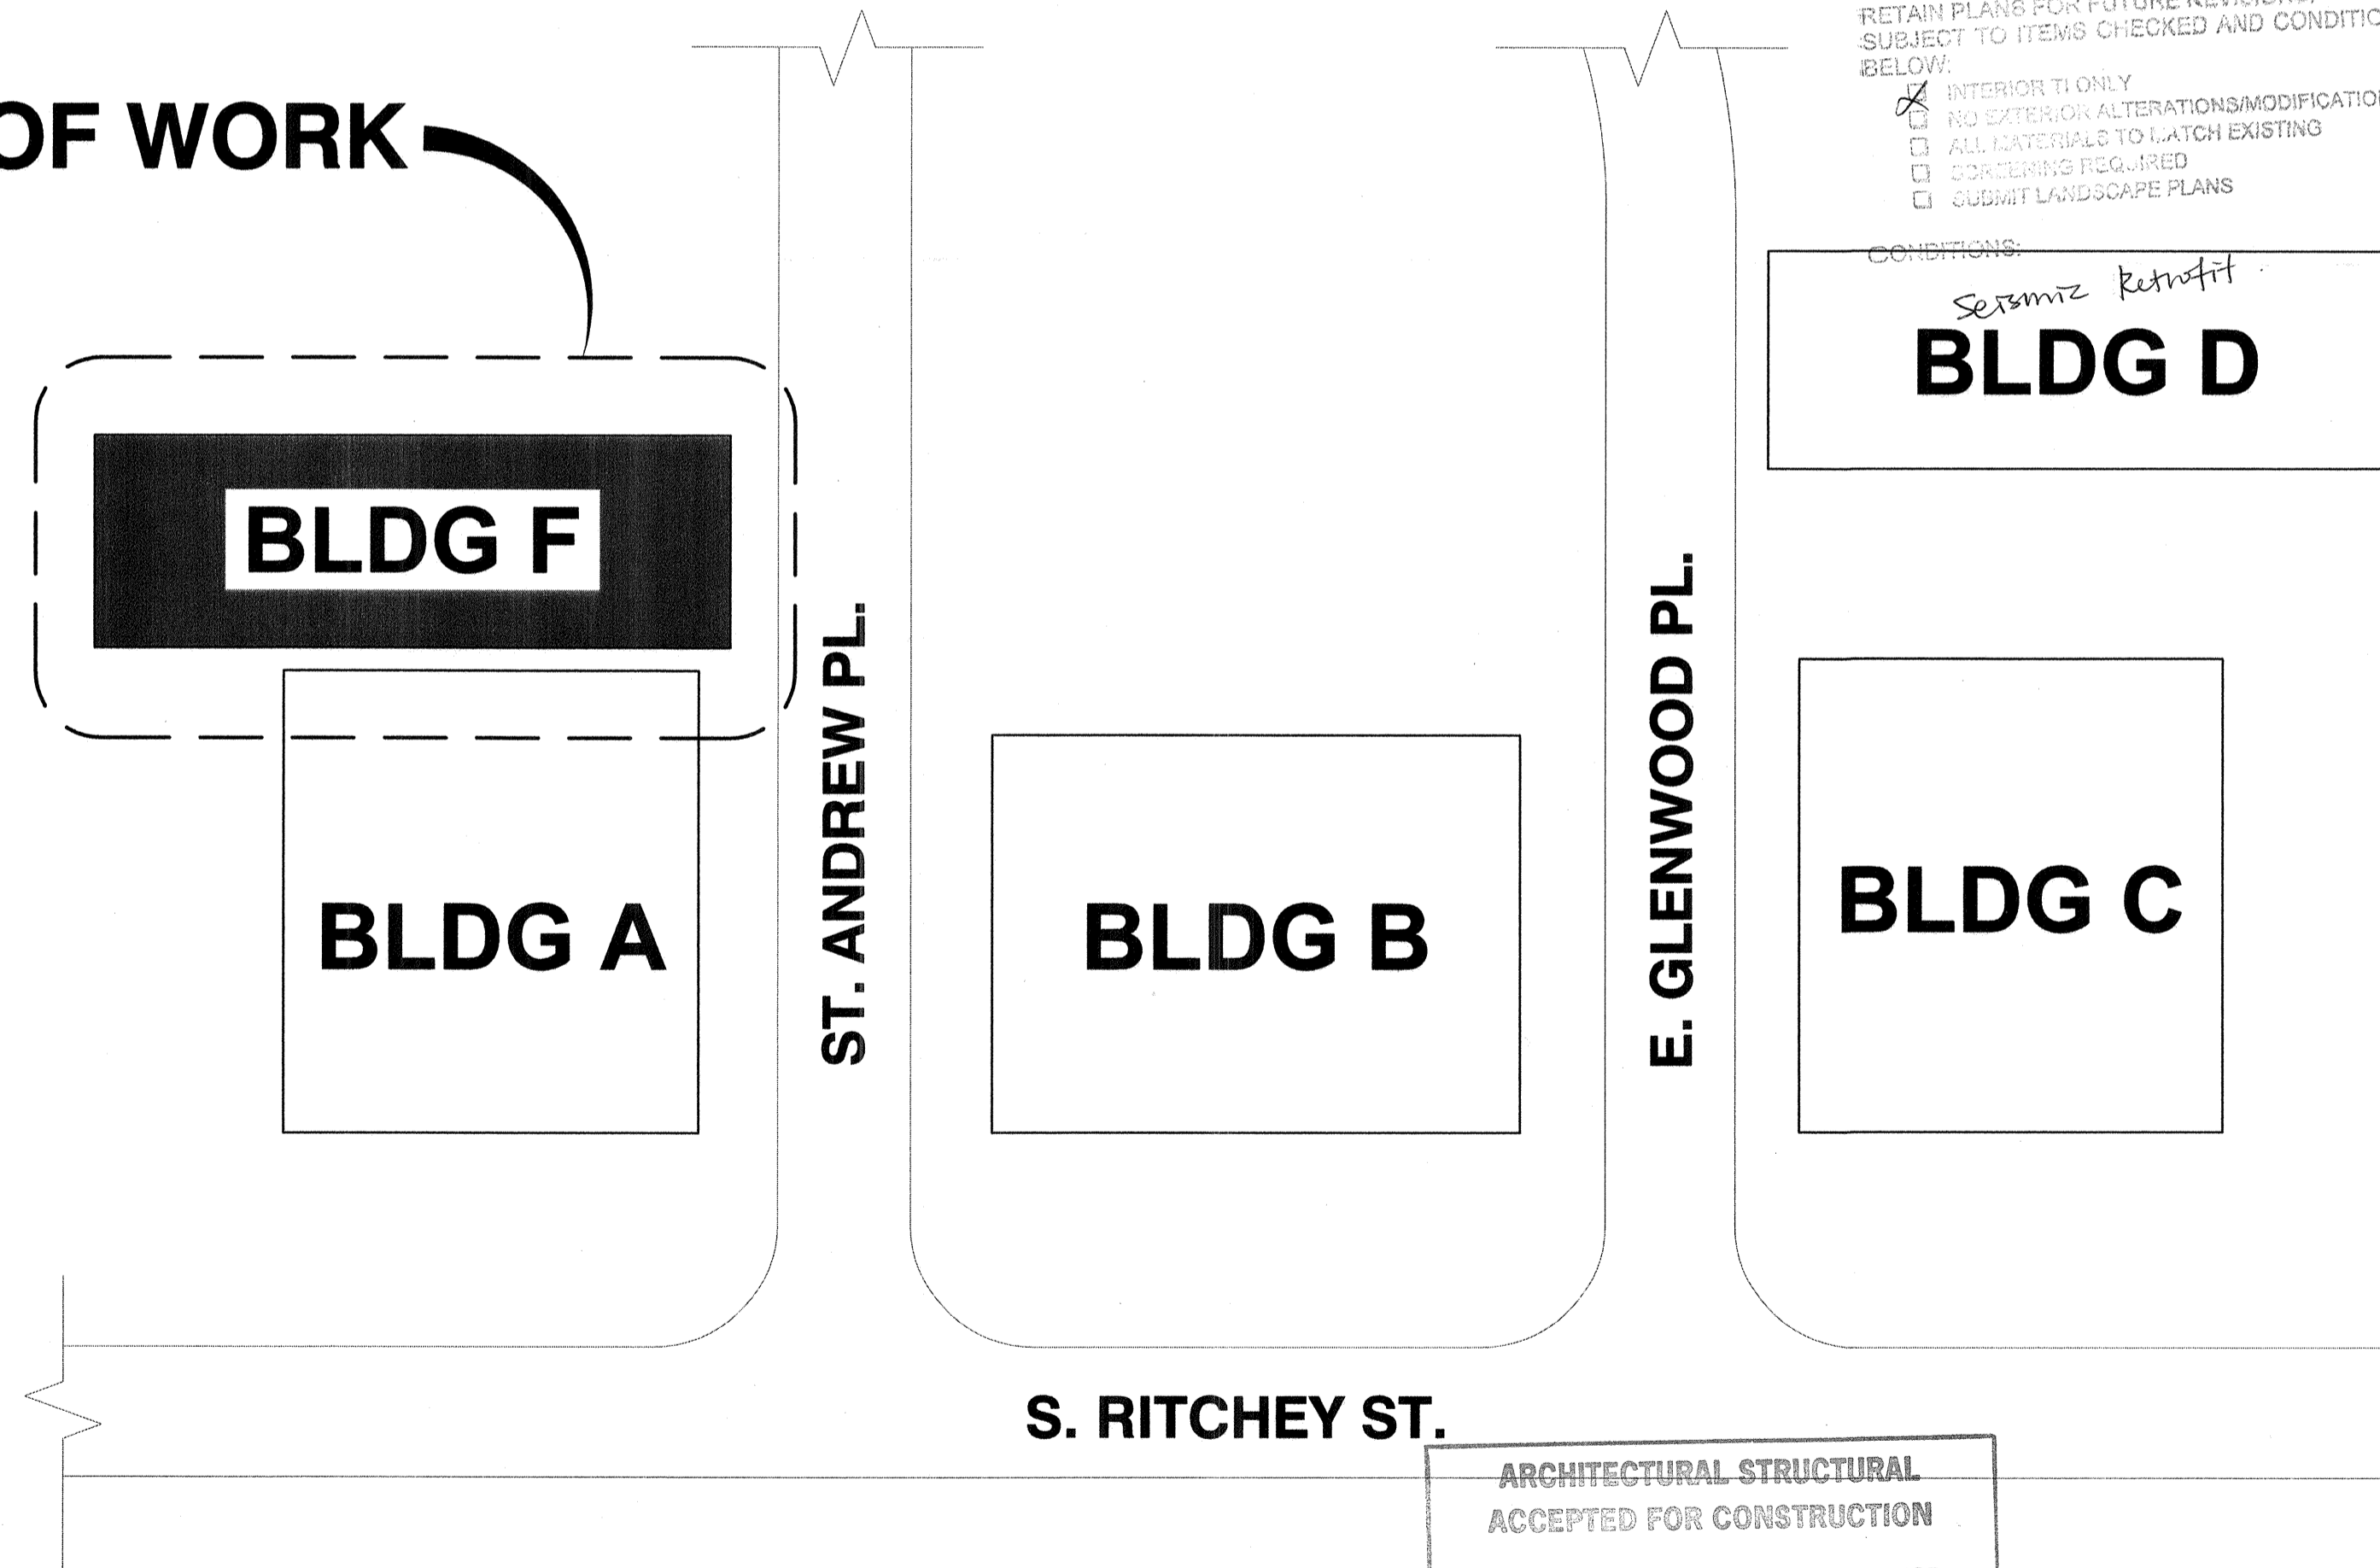

SITE PLAN (FOR REFERENCE ONLY)
NTS

ARCHITECTURAL STRUCTURAL
ACCEPTED FOR CONSTRUCTION

SEPARATE PERMITS ARE REQUIRED FOR ELECTRICAL, PLUMBING & MECHANICAL PLANS. This set of plans and specifications must be kept on the job at all times and it is unlawful to make any changes or alterations on same without written permission from the City of Santa Ana.

The acceptance of this plan and specifications SHALL NOT be held to permit nor be an approval of the violation of any provisions of ANY City Ordinance or State Law.

Accepted By: [Signature] Date: 12/11/11
CITY OF SANTA ANA

Voluntary Seismic Strengthening
AN INDUSTRIAL BLDG. RETROFIT
1917 ST. ANDREW PL. BLDG. F
SANTA ANA CA. 92705
CITY SET

JOB NO. R-Voit-001-F

REVISION:

NO.	DATE	DESCRIPTION
10/11/11	CITY SUBMITTAL	
12/05/11	RE-SUBMITTAL	



SHEET TITLE:

TITLE PAGE

SHEET NUMBER:

T-1

10173636 Retch

BASIS OF BEARINGS:
 THE BEARING NORTH 01° 20' 57" EAST BEING THE CENTERLINE OF RITCHEY STREET AS SHOWN ON PARCEL MAP NO. 796 RECORDED IN BOOK 52, PAGE 33 FILED IN THE OFFICE OF THE COUNTY RECORDER OF ORANGE COUNTY, STATE OF CALIFORNIA, WAS USED AS THE BASIS OF BEARINGS FOR THIS SURVEY.

FLOOR SPACE RESTRICTIONS:
 NONE

- LEGEND:**
- N. NORTH
 - S. SOUTH
 - E. EAST
 - W. WEST
 - TYP. TYPICAL
 - O.R. OFFICIAL RECORDS
 - P.L. PROPERTY LINE
 - CONC. CONCRETE
 - C.L. CENTER LINE
 - R. RECORD
 - M. MEASURED
 - FD. FOUND
 - T.E. TRASH ENCLOSURE
 - G.I. GRATE INLET
 - TYP. TYPICAL
 - SV. STEEL VAULT
 - W.M. WATER METER
 - EPB ELECTRICAL PULL BOX
 - M.H. MANHOLE
 - MW MONITORING WELL
 - L.S. LIGHT STANDARD
 - S.L. STREET LIGHT
 - F.H. FIRE HYDRANT
 - PP POWER POLE
 - P.A. PLANTER AREA
 - T TRANSFORMER
 - P.I.V. POST INDICATOR VALVE
 - G.M. GAS METER
 - F.D.C. FIRE DEPARTMENT CONNECTION
 - W.I.F. WROUGHT IRON FENCE
 - FSR FIRE SPRINKLER RISER
 - SMH SEWER MANHOLE
 - - - - - PROPERTY LINE
 - - - - - CENTERLINE
 - - - - - PARKING STALL
 - - - - - EASEMENT LINE
 - - - - - BUILDING LINE

LAND AREA:

PARCEL 1 : 51,575.04 SQUARE FEET 1.181 ACRES NET	PARCEL 6 : 68,171.40 SQUARE FEET 1.565 ACRES NET
PARCEL 2 : 31,537.44 SQUARE FEET 0.724 ACRES NET	PARCEL 8 : 51,052.32 SQUARE FEET 1.172 ACRES NET
PARCEL 5 : 50,137.56 SQUARE FEET 1.151 ACRES NET	PARCEL 9 : 30,492.00 SQUARE FEET 0.70 ACRES NET

TOTAL LAND AREA:
 282,965.76 SQUARE FEET
 6.496 ACRES NET

PARKING STALLS

PARCEL NO.	REGULAR	HANDICAP
1	55	3
2	38	1
5	47	3
6	129	5
8	61	3
9	26	2
TOTAL	356	17
GRAND TOTAL =	373	

TOTAL PARKING REQUIRED = 204
TOTAL PARKING PROVIDED = 373

SITE RESTRICTIONS:

SETBACKS :

- FRONT - 10'
- SIDE - N/A
- REAR - N/A
- ZONE - M-1 (LIGHT MANUFACTURING)
- HEIGHT - 35'

ALL SITE RESTRICTIONS WERE OBTAINED FROM THE CITY OF SANTA ANA (PLANNING DEPARTMENT)


NOTE:
 THE LANDSCAPE BUFFER SETBACK IS LEGAL AND NON-CONFORMING

UTILITY NOTE :
 ALL UTILITY SERVICES (SEWER, WATER, GAS, ELECTRICAL, TELEPHONE, CABLE) REQUIRED FOR THE OPERATION OF THE PREMISES ENTER THE PREMISES THROUGH ADJOINING PUBLIC STREETS AND DEDICATED EASEMENTS.



(A) Δ = 89°59'33"
 R = 15.00'
 T = 15.00'
 L = 23.56'

(B) Δ = 90°00'10"
 R = 25.40'
 T = 25.40'
 L = 39.90'

(C) Δ = 89°59'58"
 R = 195.00'
 T = 195.00'
 L = 306.30'

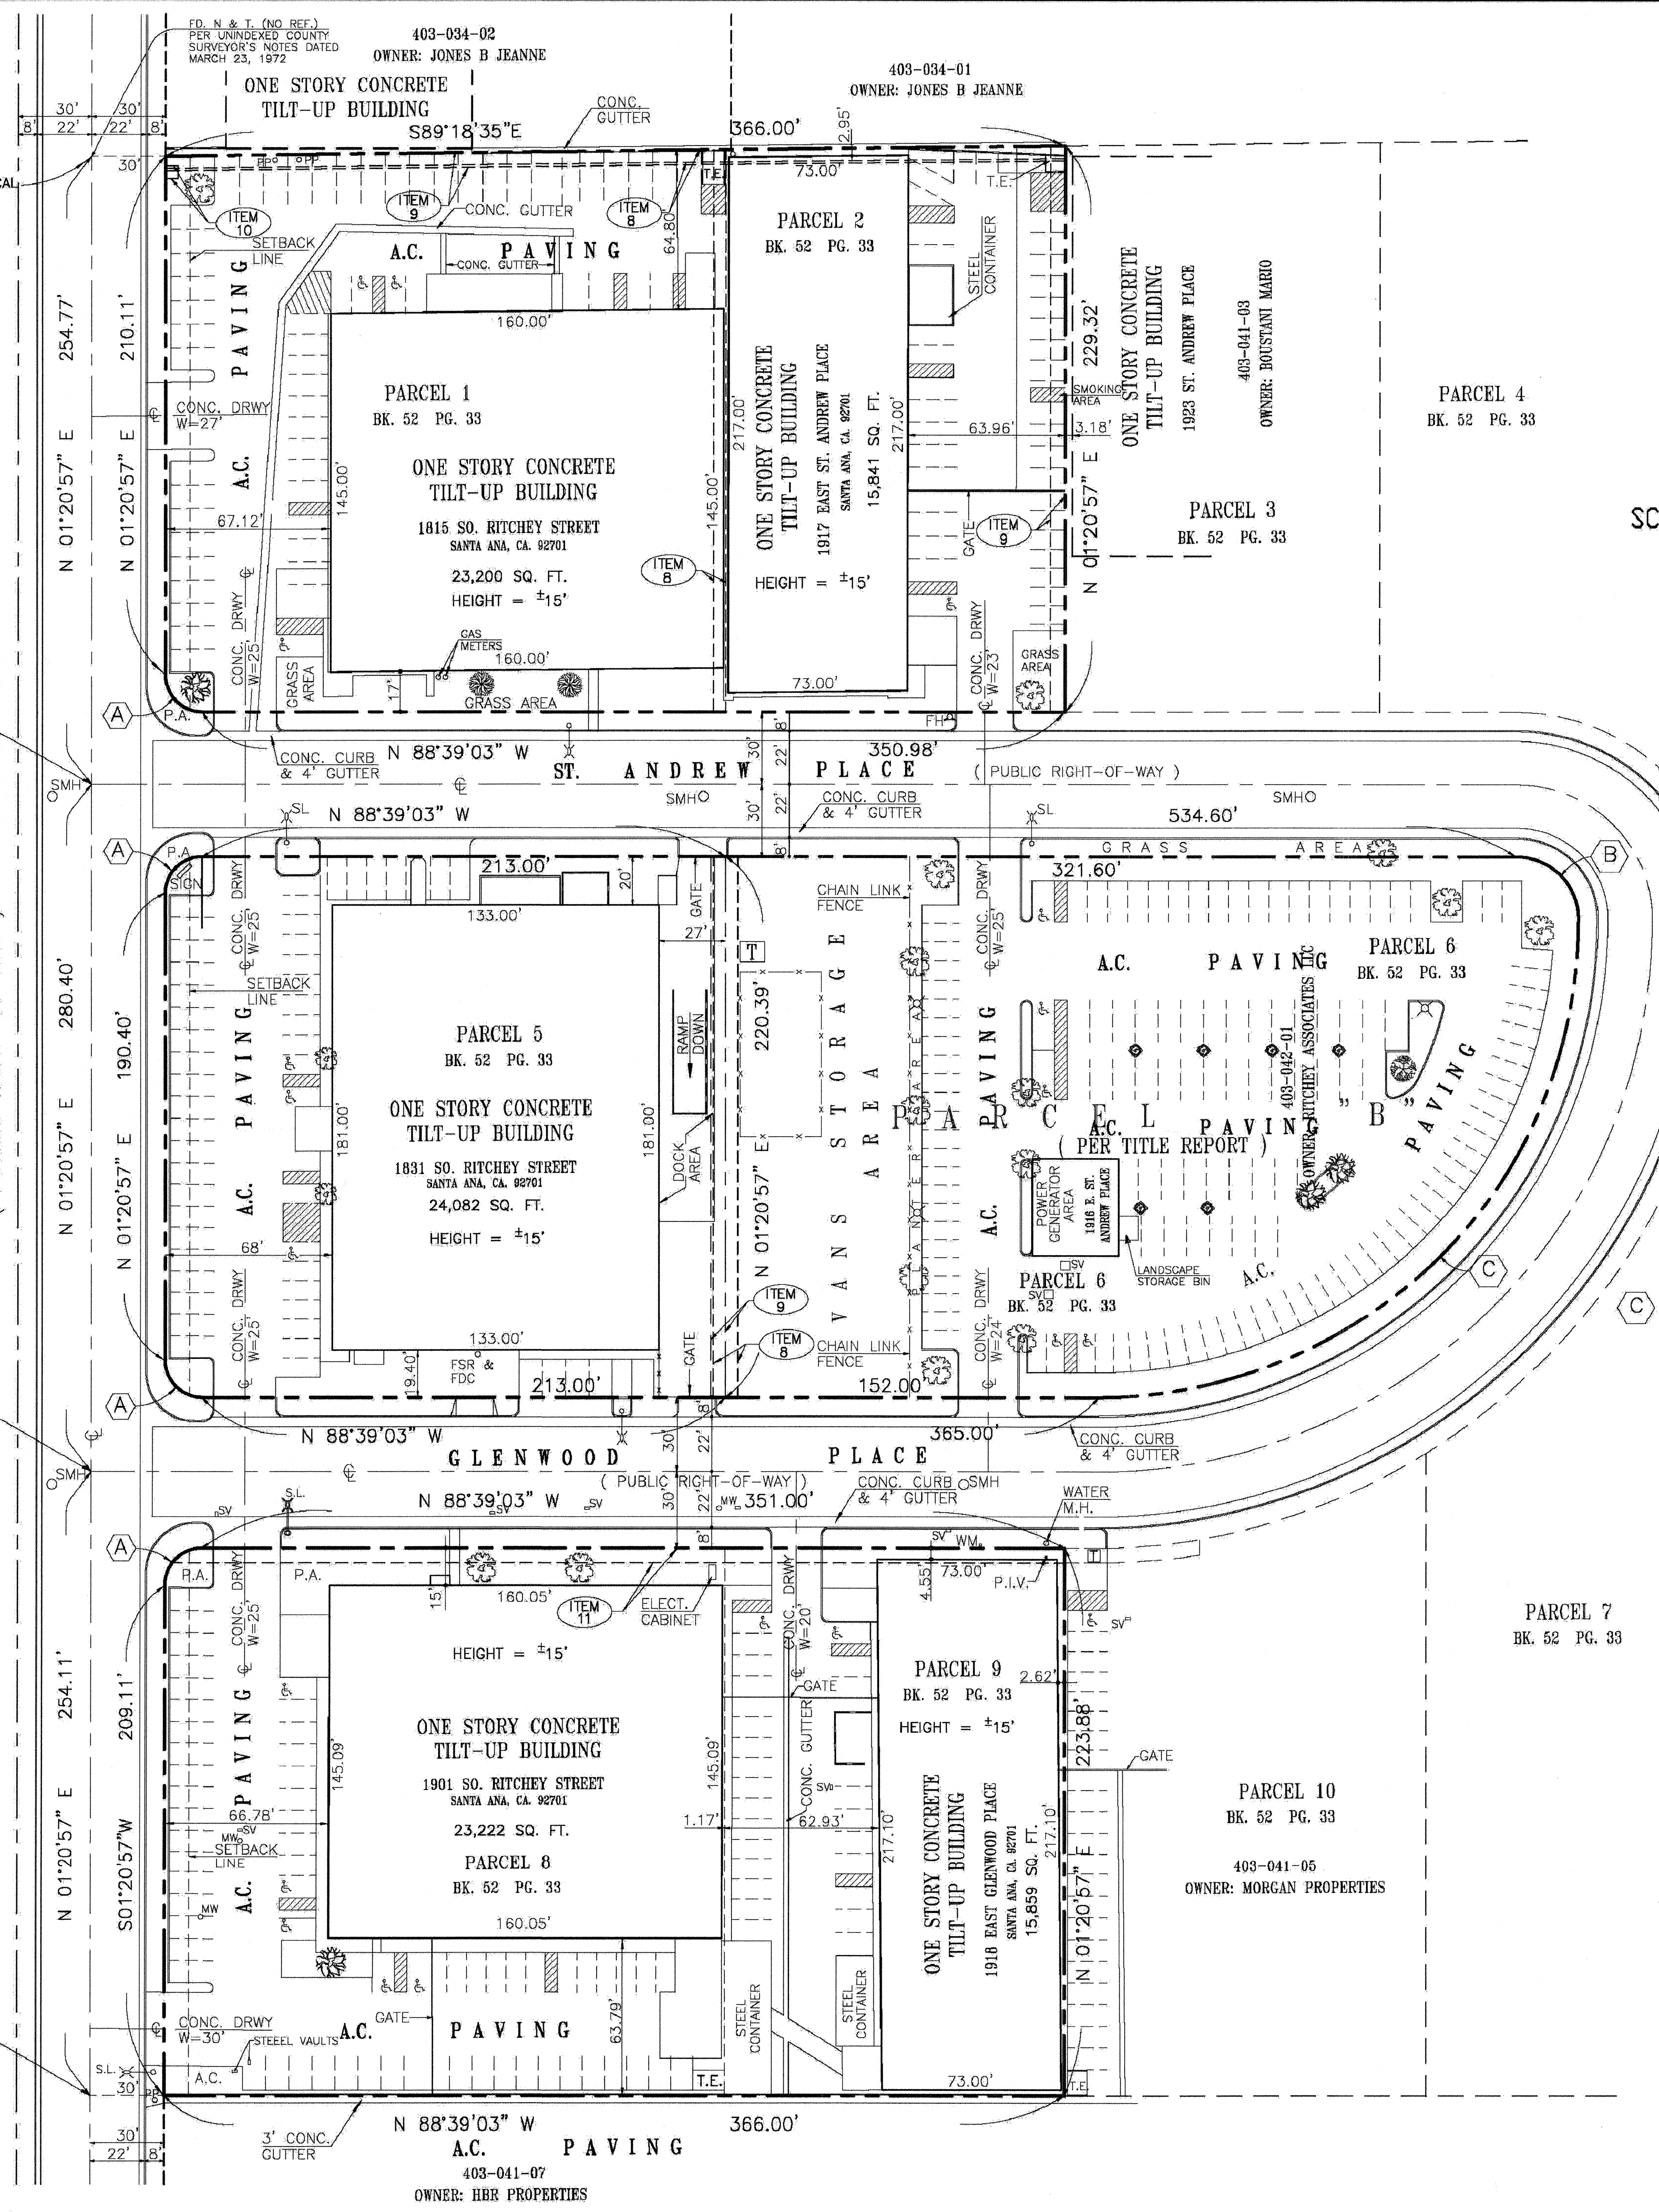

ENGINEER'S NOTES :
 THIS SURVEY HAS BEEN PREPARED FOR TITLE INSURANCE AND LENDING PURPOSES ONLY :
 1. The boundary data and title matters as shown herein have been developed from the referenced title report.
 2. This survey does not contain sufficient details for design purposes.
 3. This survey does not include easements except those specifically delineated herein, nor does it show the location of, or encroachments by, subsurface footings and/or foundations of buildings shown on this map.
 4. If underground public utilities and other subsurface structures, zones, set back and street widening data are shown herein, it is for information only, having been obtained from a general request of the local agency's public counter and/or other sources not connected with this company. No representation is made as to the accuracy, currency or completeness of said information due to changed conditions not reflected in the standard research performed for this project. Any users of said information are urged to contact the utility company or local agency directly.

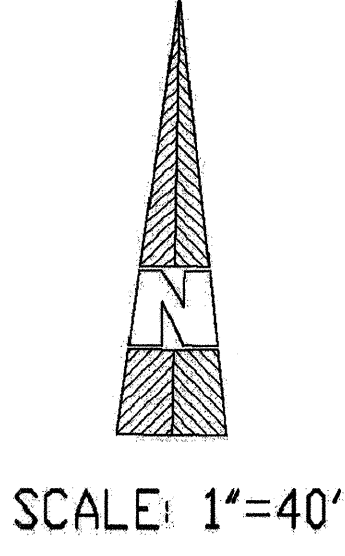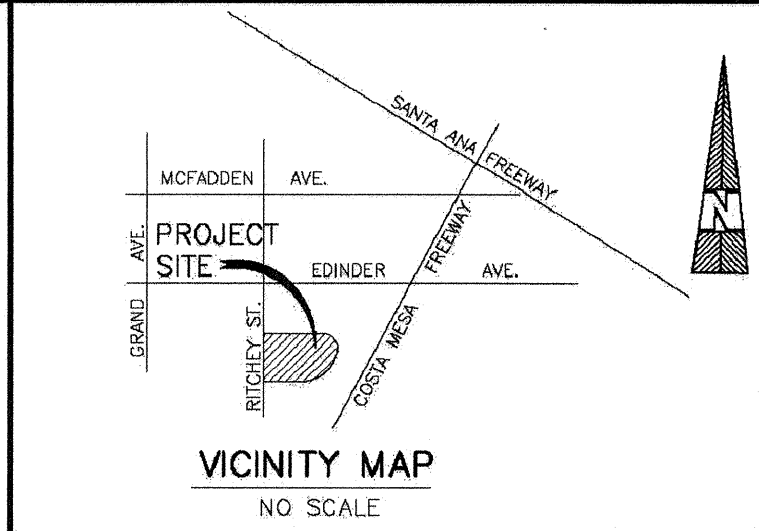

LIST OF ENCUMBRANCES :

- THE FOLLOWING ITEMS WERE FOUND IN TITLE REPORT NO. 10-725134213-A-DJ PREPARED BY FIDELITY NATIONAL TITLE COMPANY, DATED NOVEMBER 8, 2010:
- PROPERTY TAXES
 - PROPERTY TAXES
 - THE LIEN SUPPLEMENTAL TAXES
 - WATER RIGHTS, CLAIMS OR TITLE TO WATER
 - AN EASEMENT (AS PLOTTED) REC. SEPT. 29, 1967 IN BK. 8389, PG. 413 O.R.
 - AN EASEMENT (AS PLOTTED) REC. OCT. 25, 1967 IN BK. 8415, PG. 708 O.R.
 - AN EASEMENT (AS PLOTTED) REC. SEPT. 17, 1981 IN BK. 14223, PG. 3 O.R.
 - AN EASEMENT (AS PLOTTED) REC. APRIL 2, 1985 AS INST. NO. 85-116054 O.R.
 - COVENANTS, CONDITIONS AND RESTRICTIONS
 - MATTERS CONTAINED IN THAT CERTAIN DOCUMENT
 - A DEED OF TRUST
 - AN ASSIGNMENT
 - THE FACT
 - MATTERS WHICH MAY BE DISCLOSED
 - ANY EASEMENTS
 - ANY RIGHTS OF THE PARTIES IN POSSESSION
 - TITLE COMPANY REQUIREMENTS
 - TITLE COMPANY REQUIREMENTS

LEGAL DESCRIPTION: (PER TITLE REPORT)

THE LAND REFERRED TO HEREIN BELOW IS SITUATED IN THE CITY OF SANTA ANA, COUNTY OF ORANGE, STATE OF CALIFORNIA, AND IS DESCRIBED AS FOLLOWS:
PARCEL A:
 PARCELS 1, 2, 5, 6, 8 AND 9, IN THE CITY OF SANTA ANA, COUNTY OF ORANGE, STATE OF CALIFORNIA, AS SHOWN ON A MAP FILED IN BOOK 52, PAGE 33 OF PARCEL MAPS, IN THE OFFICE OF THE COUNTY RECORDER OF SAID COUNTY.
PARCEL B:
 NON-EXCLUSIVE EASEMENTS FOR INSTALLATION AND MAINTENANCE OF ELECTRIC, TELEPHONE, WATER, GAS, SANITARY SEWER LINES AND DRAINAGE FACILITIES; INSPECTION AND MAINTENANCE; AND ENCROACHMENTS ALL AS MORE PARTICULARLY DESCRIBED IN THE "DECLARATION OF COVENANTS, CONDITIONS, RESTRICTIONS AND RESERVATION FOR EASEMENTS FOR RITCHEY CENTRE", RECORDED AUGUST 23, 1985 AS INSTRUMENT NO. 85-317869 AND MODIFIED BY MODIFICATION RECORDED AUGUST 21, 2000 AS INSTRUMENT NO. 20000436442, BOTH OF OFFICIAL RECORDS.
 APN: 403-041-01, 403-041-02, 403-041-09, 403-041-10, 403-042-02, 403-042-01

FLOOD NOTE:

BY GRAPHIC PLOTTING ONLY, THIS PROPERTY IS IN ZONE "X" OF THE FLOOD INSURANCE RATE MAP, COMMUNITY PANEL NO. 060232, PANEL 0038FC, WHICH BEARS AN EFFECTIVE DATE OF 06-14-2000 AND IS NOT IN A SPECIAL FLOOD HAZARD AREA.

ENGINEER'S CERTIFICATION :

I AM A REGISTERED PUBLIC ENGINEER IN THE STATE OF CALIFORNIA AND I HEREBY CERTIFY TO RITCHEY ASSOCIATES, LLC, A CALIFORNIA LIMITED LIABILITY COMPANY, FIDELITY NATIONAL TITLE COMPANY AND TO JACKSON NATIONAL LIFE INSURANCE COMPANY AND TO ANY OF THEIR AFFILIATES, SUCCESSORS AND ASSIGNS, THAT I UNDERSTAND THAT THE AFOREMENTIONED TITLE INSURER WILL RELY ON THE ACCURACY AND COMPLETENESS OF THE SURVEY PLAT AND THE TRUTH OF MY CERTIFICATIONS IN INSURING A POLICY OF TITLE INSURANCE ASSURING THE VALIDITY AND PRIORITY OF THE LIEN OF A MORTGAGE OR DEED OF TRUST ON THE PREMISES AND LENDER WILL SO RELY IN DETERMINING WHETHER TO FUND THE RELATED LOAN. THIS SURVEY IS MADE IN ACCORDANCE WITH THE "MINIMUM STANDARD REQUIREMENTS FOR ALTA/ACSM LAND TITLE SURVEY" JOINTLY ESTABLISHED AND ADOPTED BY ALTA AND NSPS IN 2005; AND INCLUDES ITEMS 2, 3, 4, 6, 7(b)(1), 8, 9, 10, 11(g) AND 14 OF TABLE A THEREOF, PURSUANT TO THE ACCURACY STANDARDS AS ADOPTED BY ALTA AND NSPS AND IN EFFECT ON THE DATE OF THIS CERTIFICATION, UNDERSIGNED FURTHER CERTIFIES THAT IN MY PROFESSIONAL OPINION, AS A PROFESSIONAL ENGINEER REGISTERED IN THE STATE OF CALIFORNIA, THE RELATIVE POSITIONAL ACCURACY OF THIS SURVEY DOES NOT EXCEED THAT WHICH IS SPECIFIED IN THE CURRENT ACCURACY STANDARDS FOR ALTA/ACSM LAND TITLE SURVEYS.



DAVID J. MACARTHUR, R.C.E. 12502 DATE 12-16-2011

NATIONAL ENGINEERING & CONSULTING, INC.
 27 ORCHARD LAKE FOREST, CA. 92660
 PHONE: (949) 715-9900
 FAX: (949) 715-9907

Voluntary Seismic Strengthening
 AN INDUSTRIAL BLDG. RETROFIT
 1917 ST. ANDREW PL. BLDG. F
 SANTA ANA CA. 92705

JOB NO. R-Vol-001-F


REVISION:

NO.	DATE	DESCRIPTION
10/11/11	CITY SUBMITTAL	
12/05/11	RE-SUBMITTAL	

FOR REFERENCE ONLY

SHEET TITLE:
ALTA SURVEY

SHEET NUMBER:
T-2

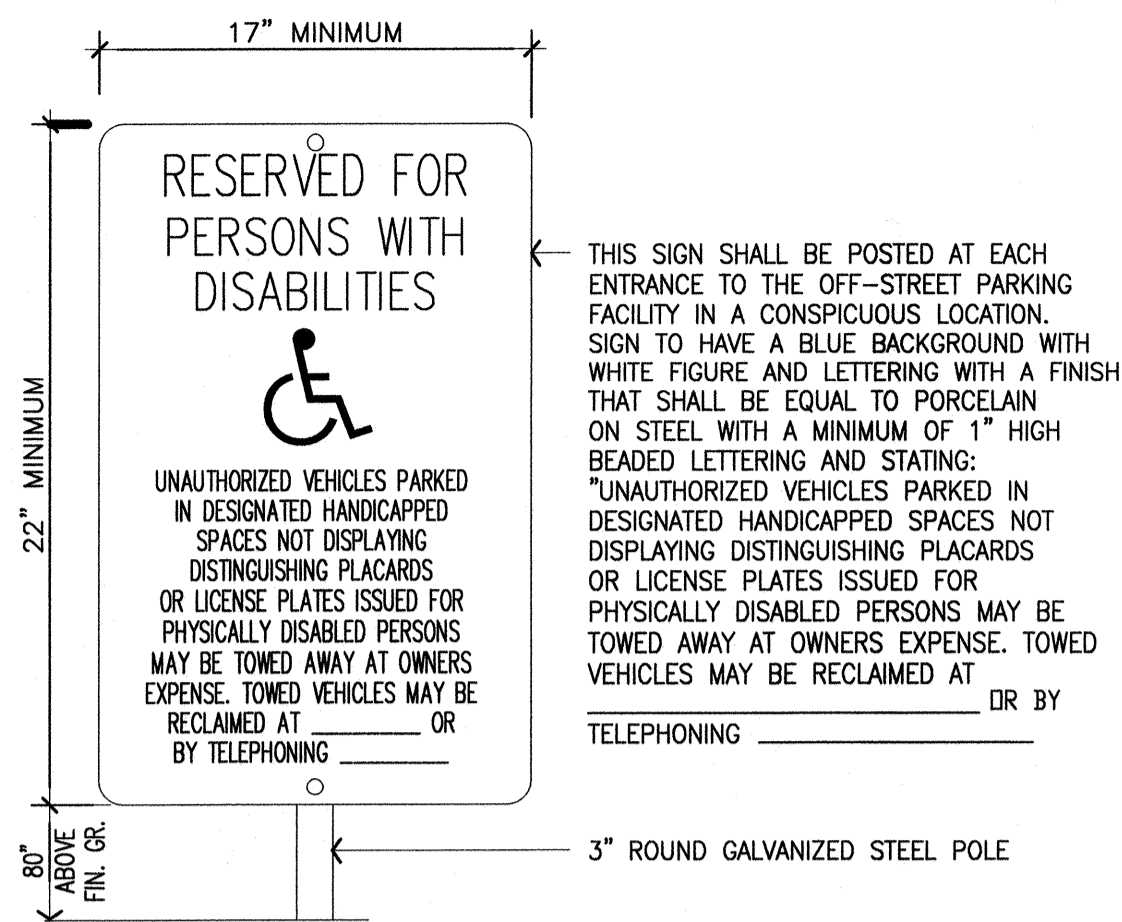

PARKING ENTRANCE SIGN

SCALE: 8

ACCESSIBLE SIGNAGE

SCALE: N.T.S.



NOTES:
 1. EACH PARKING SPACE FOR THE DISABLED IS REQUIRED TO BE IDENTIFIED BY A PERMANENT, REFLECTORIZED SIGN WITH THE INTERNATIONAL SYMBOL OF ACCESSIBILITY.
 2. PROVIDE ADDITIONAL SIGNAGE, READING: "MINIMUM FINE \$250" BELOW THE INTERNATIONAL SYMBOL OF ACCESSIBILITY AS EITHER AN ADDITIONAL SIGN OR ADDITIONAL LANGUAGE.

ACCESSIBLE PARKING (TYP.)

SCALE: N.T.S.



NOTES:
 1. CROSS SLOPE OF STALL SHALL NOT EXCEED 2%
 2. SLOPE OF PARKING STALL AND SIDE AISLE LOADING AREA TO BE 5% MAXIMUM TO ZERO CURB FACE

SYMBOL OF ACCESIBILITY


SCALE: N.T.S.



1 3/4" WIDE STRIPES - COLOR PER STATE HANDICAP ACCESSIBILITY STANDARDS


- 1 REMOVE (E) STRIPING AND RE-STRIP (E) H.C. SPACE PER DETAILS: (5) (6)
- 2 PROVIDE (N) ADA SIGNAGE (7)
- 3 PROVIDE (N) ADA SIGNAGE AT MAIN PARKING ENTRANCE (8)
- 4 PROVIDE (N) H.C. STRIPING & 48" WIDE STRIPING FOR PATH OF TRAVEL AND 12" HIGH LETTERS "NO PARKING" & "VAN ACCESSIBLE" PER DETAILS: (5) (6)
- 5 RELOCATE EXISTING PAPER TOWEL DISPENSERS SO THAT DISPENSER PORTION OF UNIT IS 46" A.F.F., MAX. (VERIFY IN ALL RESTROOMS)
- 6 REPLACE (E) DRINKING FOUNTAIN WITH A NEW ADA COMPLIANT DRINKING FOUNTAIN. SEE BELOW FOR SPEC. MAINTAIN 2'-8" SIDE TO SIDE CLEARANCE, AND A 30"x48" CLEAR FLOOR AREA IN FRONT OF FOUNTAIN.
NEW DRINKING FOUNTAIN SPEC:
 BRAND: ELKAY
 MODEL # EZSDL ADA BARRIER FREE FOUNTAIN
 MOUNT PER MANUFACTURER'S RECOMMENDATIONS.
- 7 REMOVE (E) PLANTING AS NEEDED, CAP (E) SPRINKLER LINES, AND APPLY 4" THK ASPHALT TO MATCH GRADE WITH 2% MAX. SLOPE AWAY FROM BUILDING.
- 8 (E) TREE TO REMAIN.

KEYNOTES

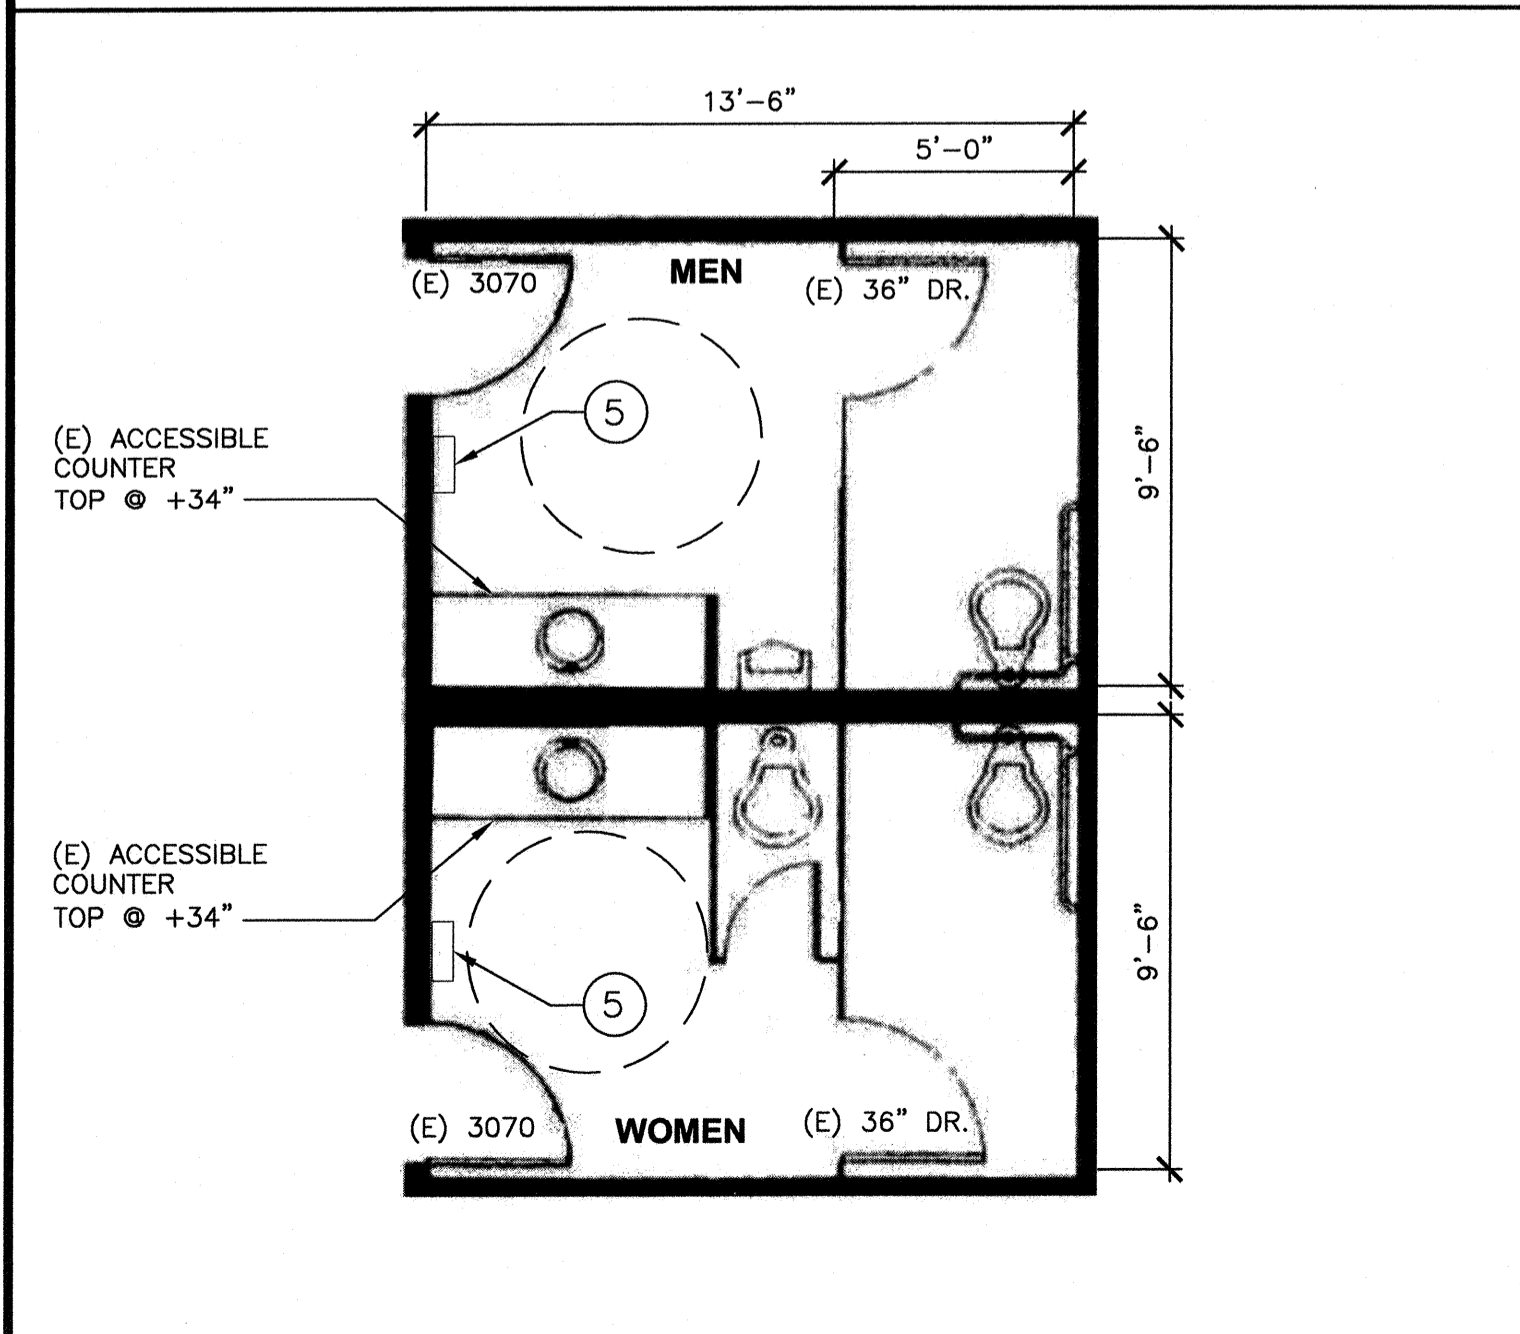

EXISTING RESTROOMS

SCALE: 1/4"=1'-0" 2

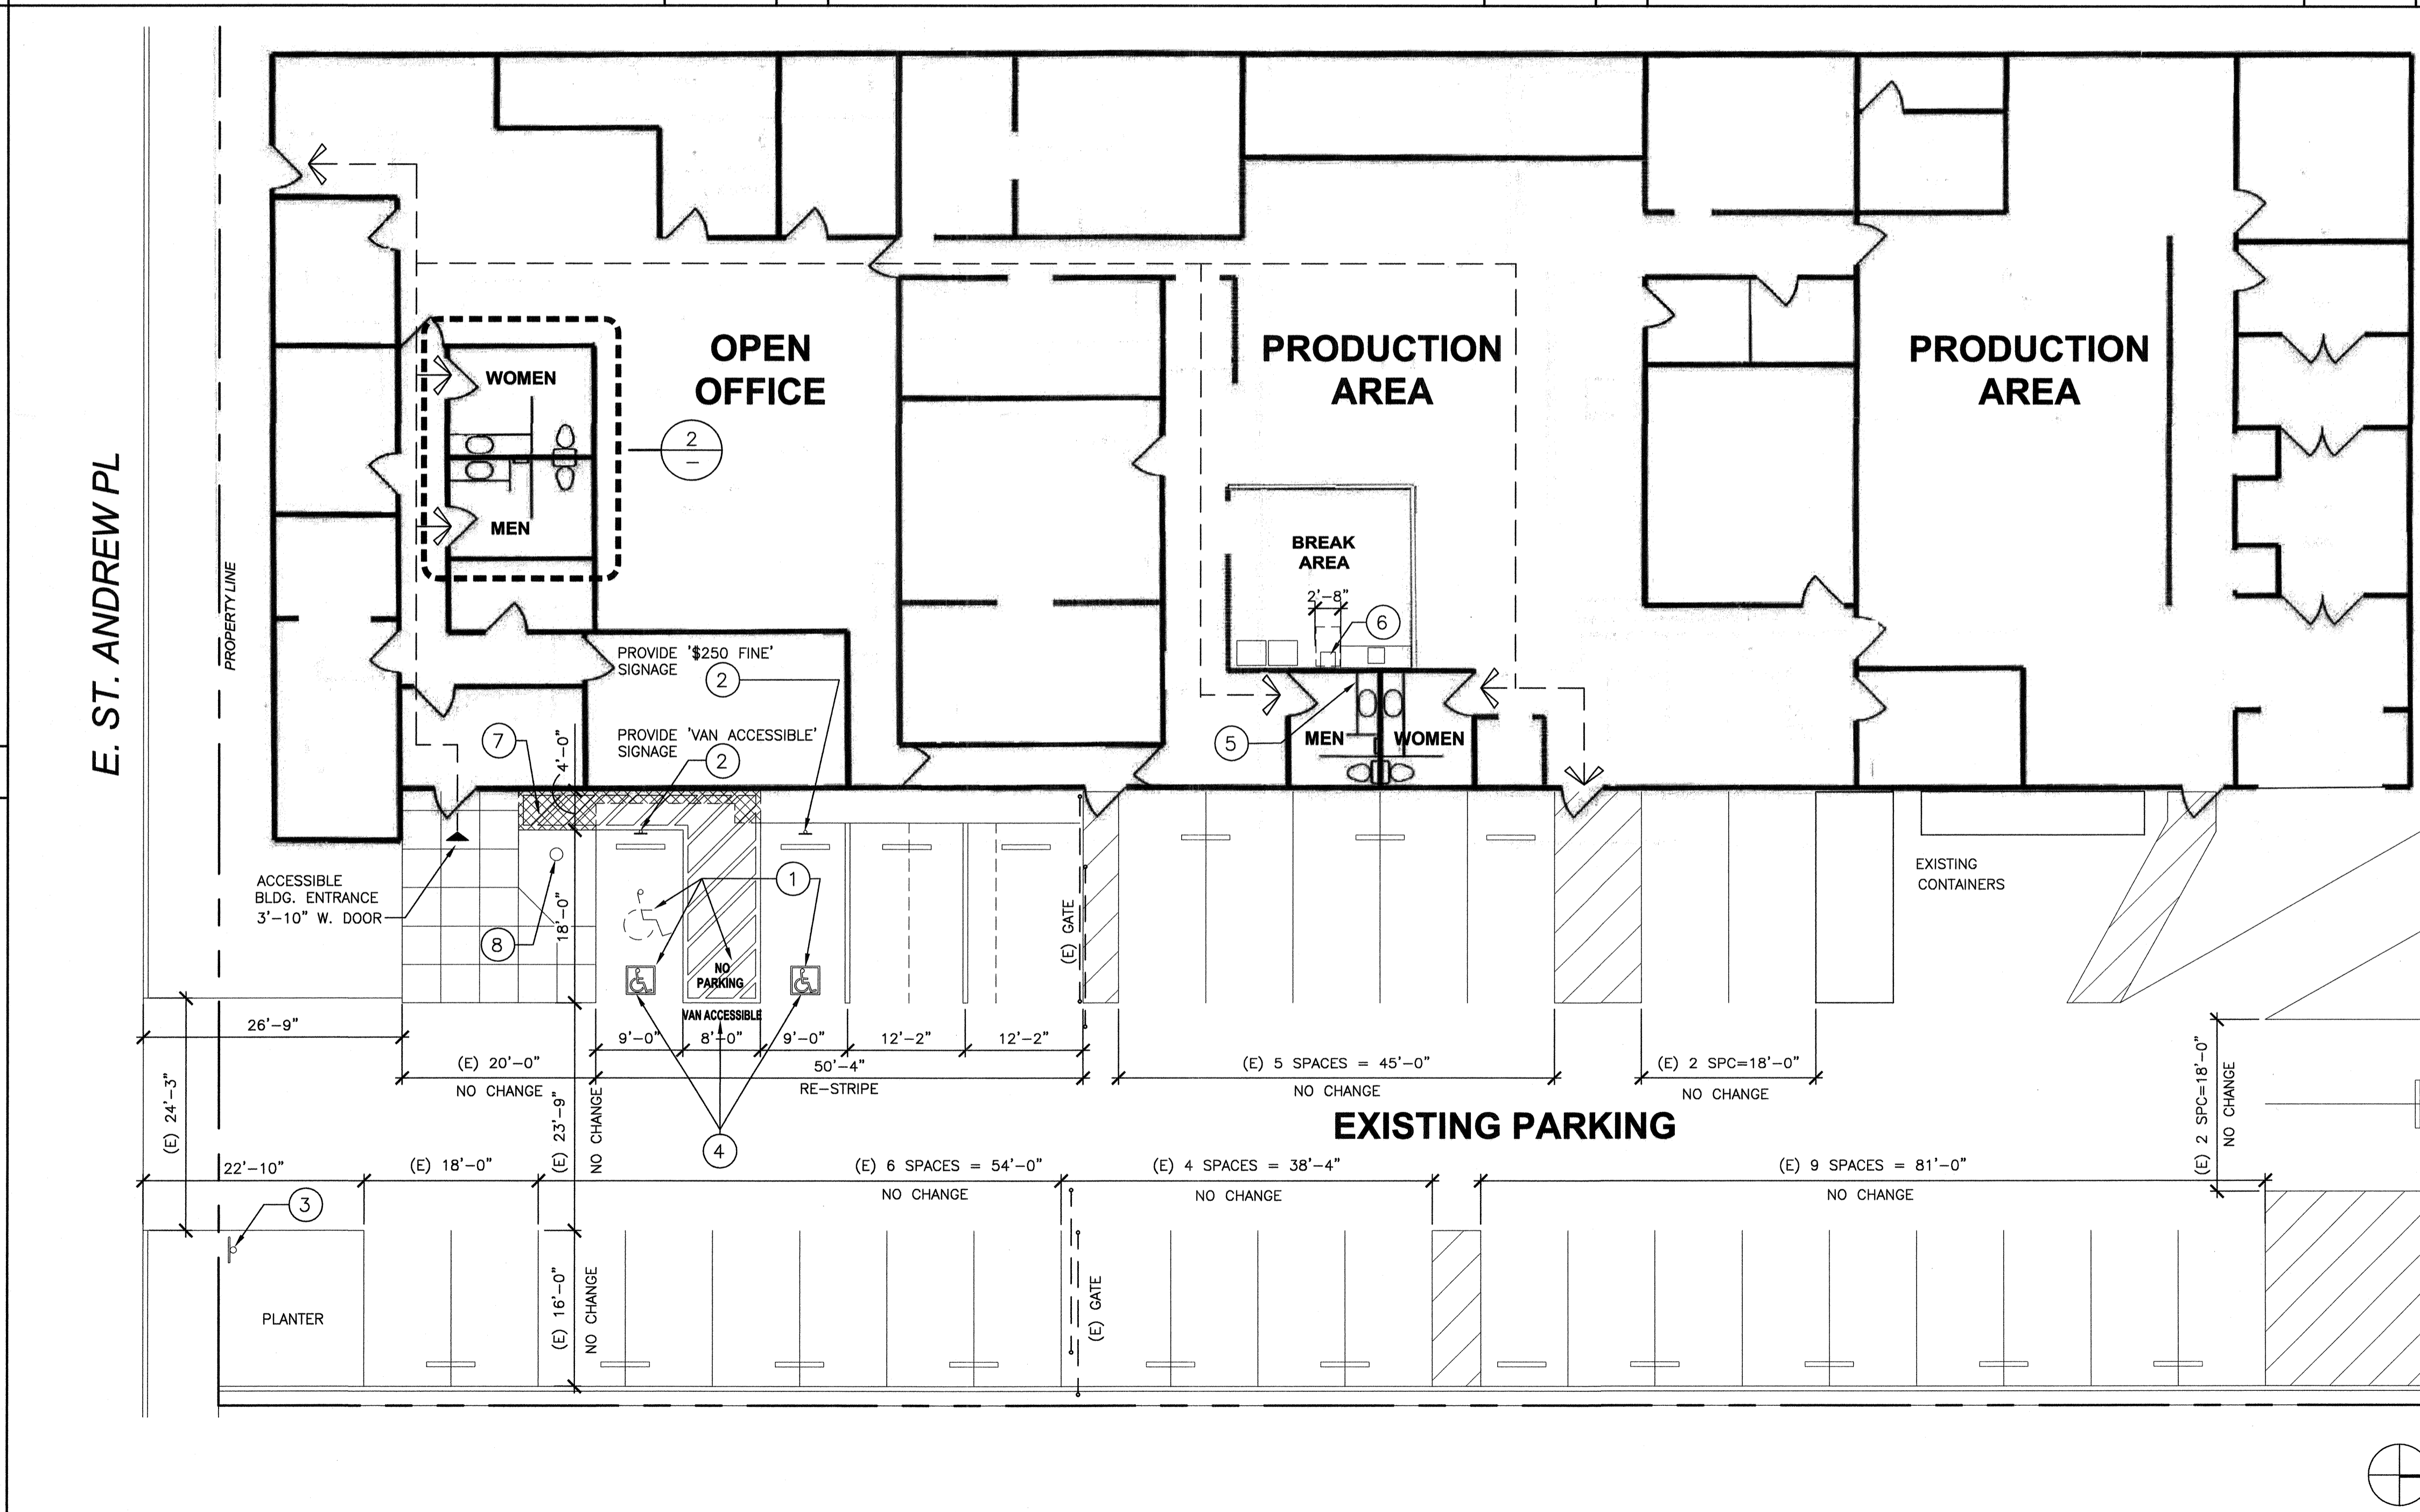

ENLARGED OFFICE AREA / FLOOR PLAN


SCALE: 3/32"=1'-0" 1

NATIONAL ENGINEERING & CONSULTING, INC.
 27 ORCHARD LANE
 LAKEVIEW, CA 94590
 PHONE: (925) 716-0900
 FAX: (925) 716-0997

Voluntary Seismic Strengthening
 AN INDUSTRIAL BLDG. RETROFIT
 1917 ST. ANDREW PL. BLDG. F
 SANTA ANA CA. 92705

JOB NO. R-Vol-001-F

REVISION:	
10/11/11	CITY SUBMITTAL
12/05/11	RE-SUBMITTAL
12/15/11	PLN CHK COMM

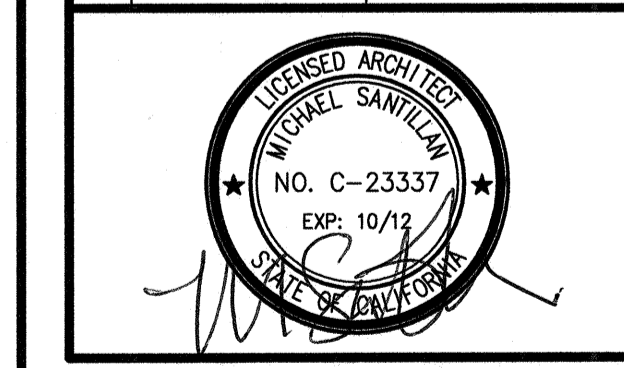

SHEET TITLE:
ADA UPGRADES PLAN

SHEET NUMBER:
A-1

Voluntary Seismic Strengthening
AN INDUSTRIAL BLDG. RETROFIT
1917 ST. ANDREW PL. BLDG. F
SANTA ANA CA. 92705

JOB NO. R-Voit-001-F

REVISION:		
10/11/11	CITY SUBMITTAL	
12/05/11	RE-SUBMITTAL	




SHEET TITLE:

ROOF FRAMING PLAN

SHEET NUMBER:


S-1

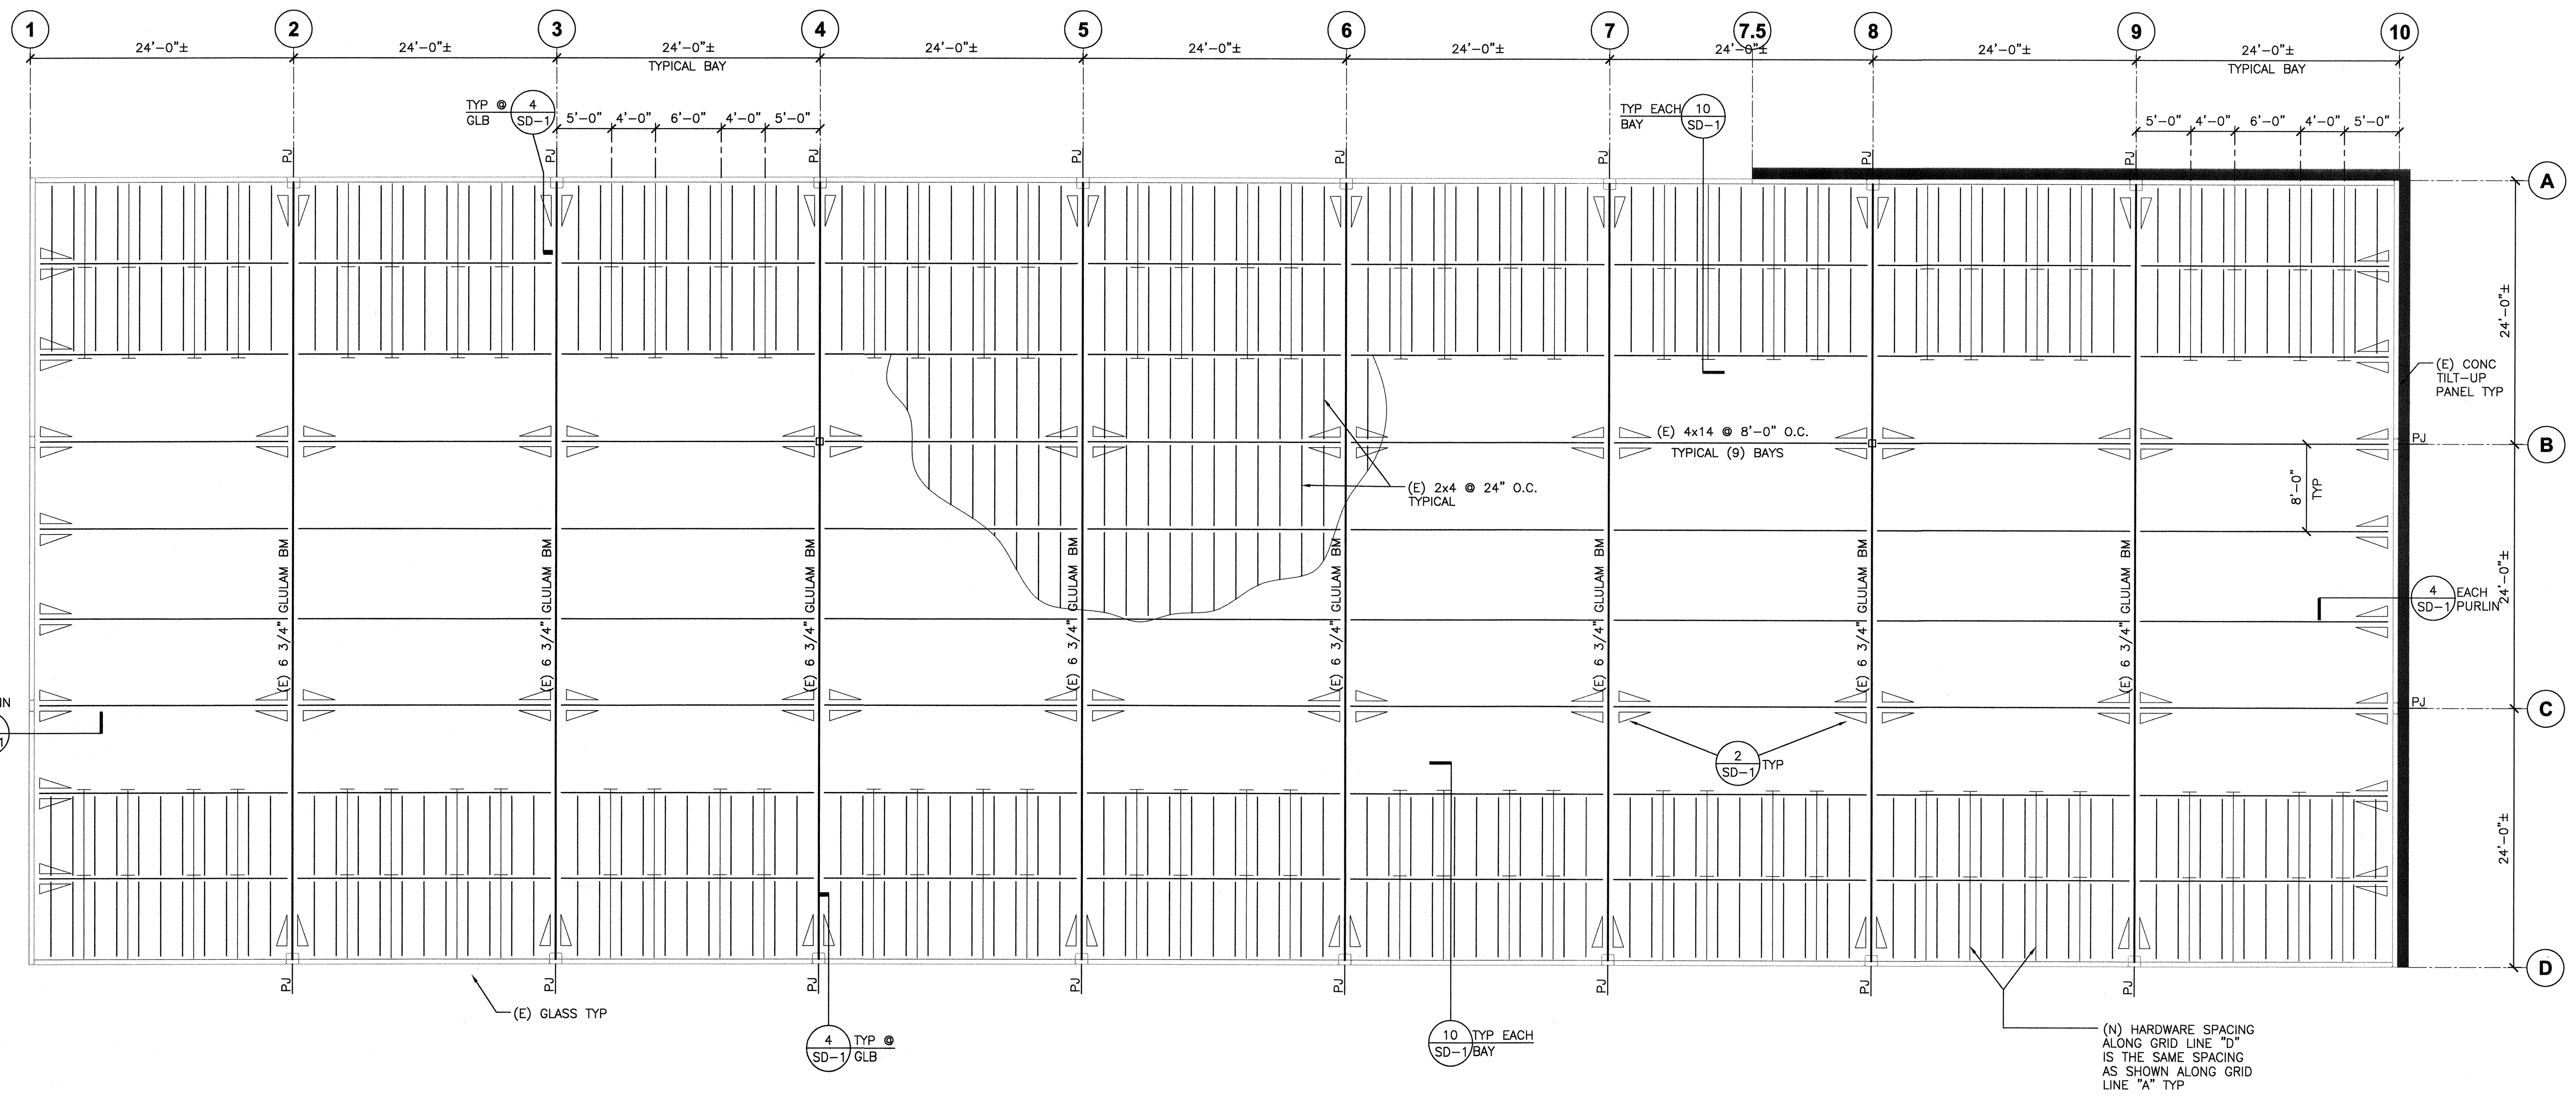

ROOF FRAMING NOTES


- CONTRACTORS RESPONSIBLE FOR THE CONSTRUCTION OF A WIND OR SEISMIC FORCE RESISTING SYSTEM/COMPONENT LISTED IN THE "STATEMENT OF SPECIAL INSPECTION" SHALL SUBMIT A WRITTEN STATEMENT OF RESPONSIBILITY TO THE LADDS INSPECTORS AND THE OWNER PRIOR TO THE COMMENCEMENT OF WORK ON SUCH SYSTEM OR COMPONENT PER SEC 1706.1
- CONTINUOUS SPECIAL INSPECTION BY A REGISTERED DEPUTY INSPECTOR IS REQUIRED FOR FIELD WELDING, CONCRETE STRENGTH $f'c > 2500$ PSI, HIGH STRENGTH BOLTING, SPRAYED ON FIREPROOFING, ENGINEERED MASONRY, HIGH LIFT GROUTING, PRE-STRESSED CONCRETE, HIGH LOAD DIAPHRAGMS AND EPOXY ANCHORS.
- IF ADVERSE SOIL CONDITIONS ARE ENCOUNTERED, A SOILS INVESTIGATION REPORT MAY BE REQUIRED.

LEGEND

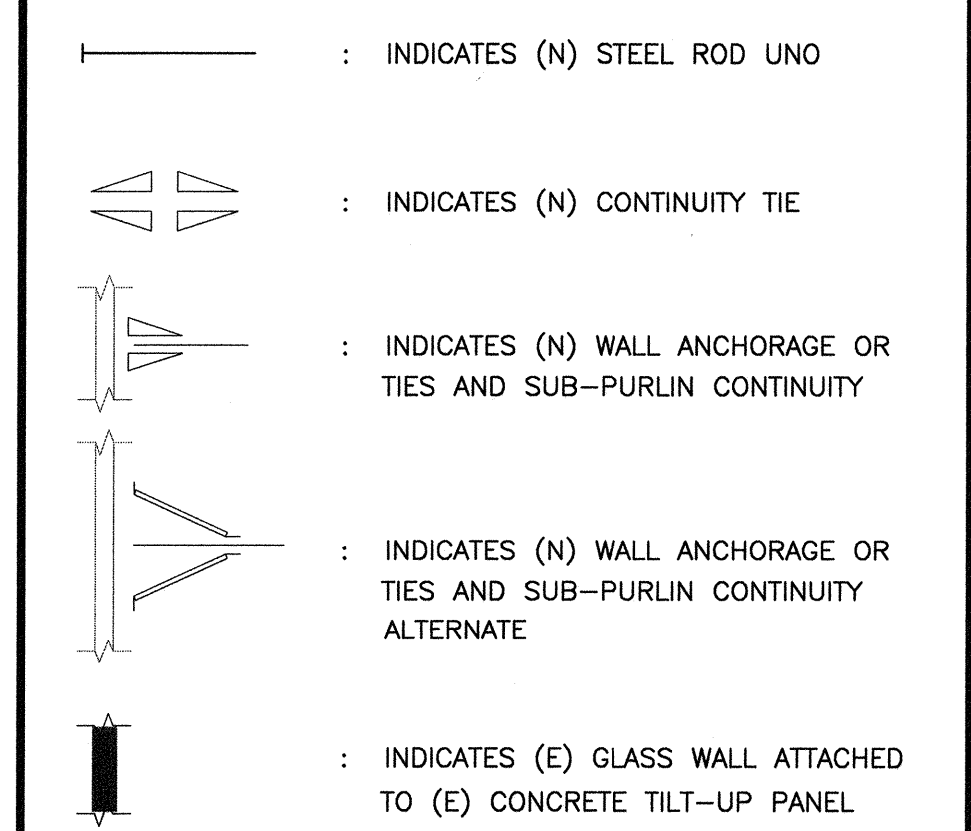




WALLS	(E) WALL THICKNESS	TOP OF PARAPET ELEVATION	TOP OF ROOF ELEVATION
<ul style="list-style-type: none"> ● GRID 1 ● GRID A, FROM 1 TO 7.5 ● GRID D 	5-1/2"	± 17'-5"	VARIABLE BETWEEN 15'-8" AND 17'-0"
<ul style="list-style-type: none"> ● GRID 10 ● GRID A, FROM 7.5 TO 10 	5-1/2"	± 17'-4" (GLASS TO 18'-6")	VARIABLE BETWEEN 15'-8" AND 17'-0"

KEY PLAN

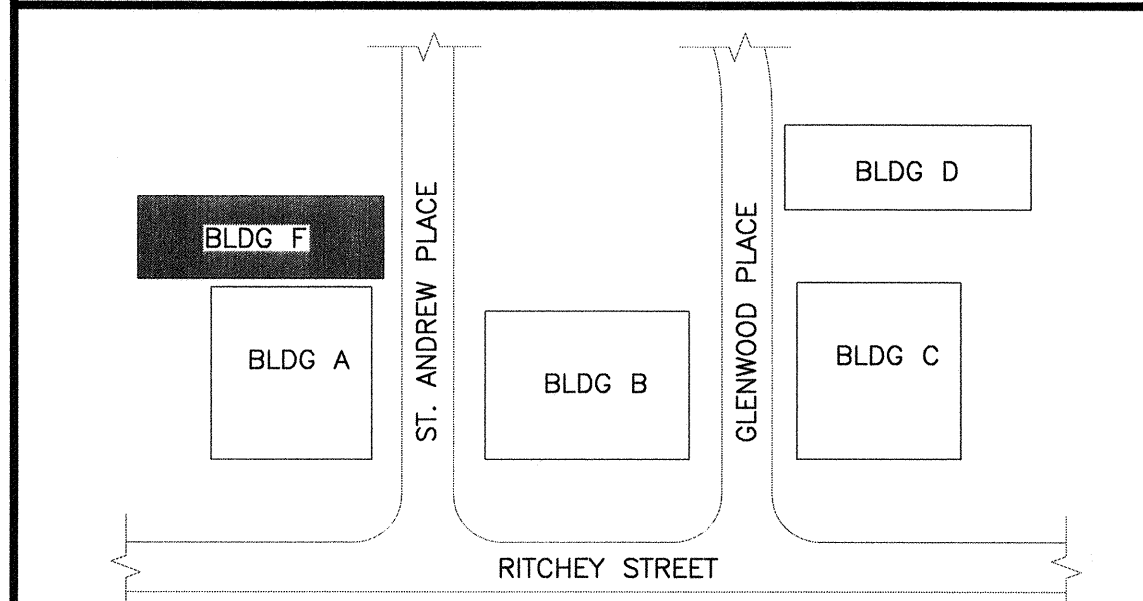

SCALE: 1/8" = 1'-0" 1





ROOF FRAMING PLAN

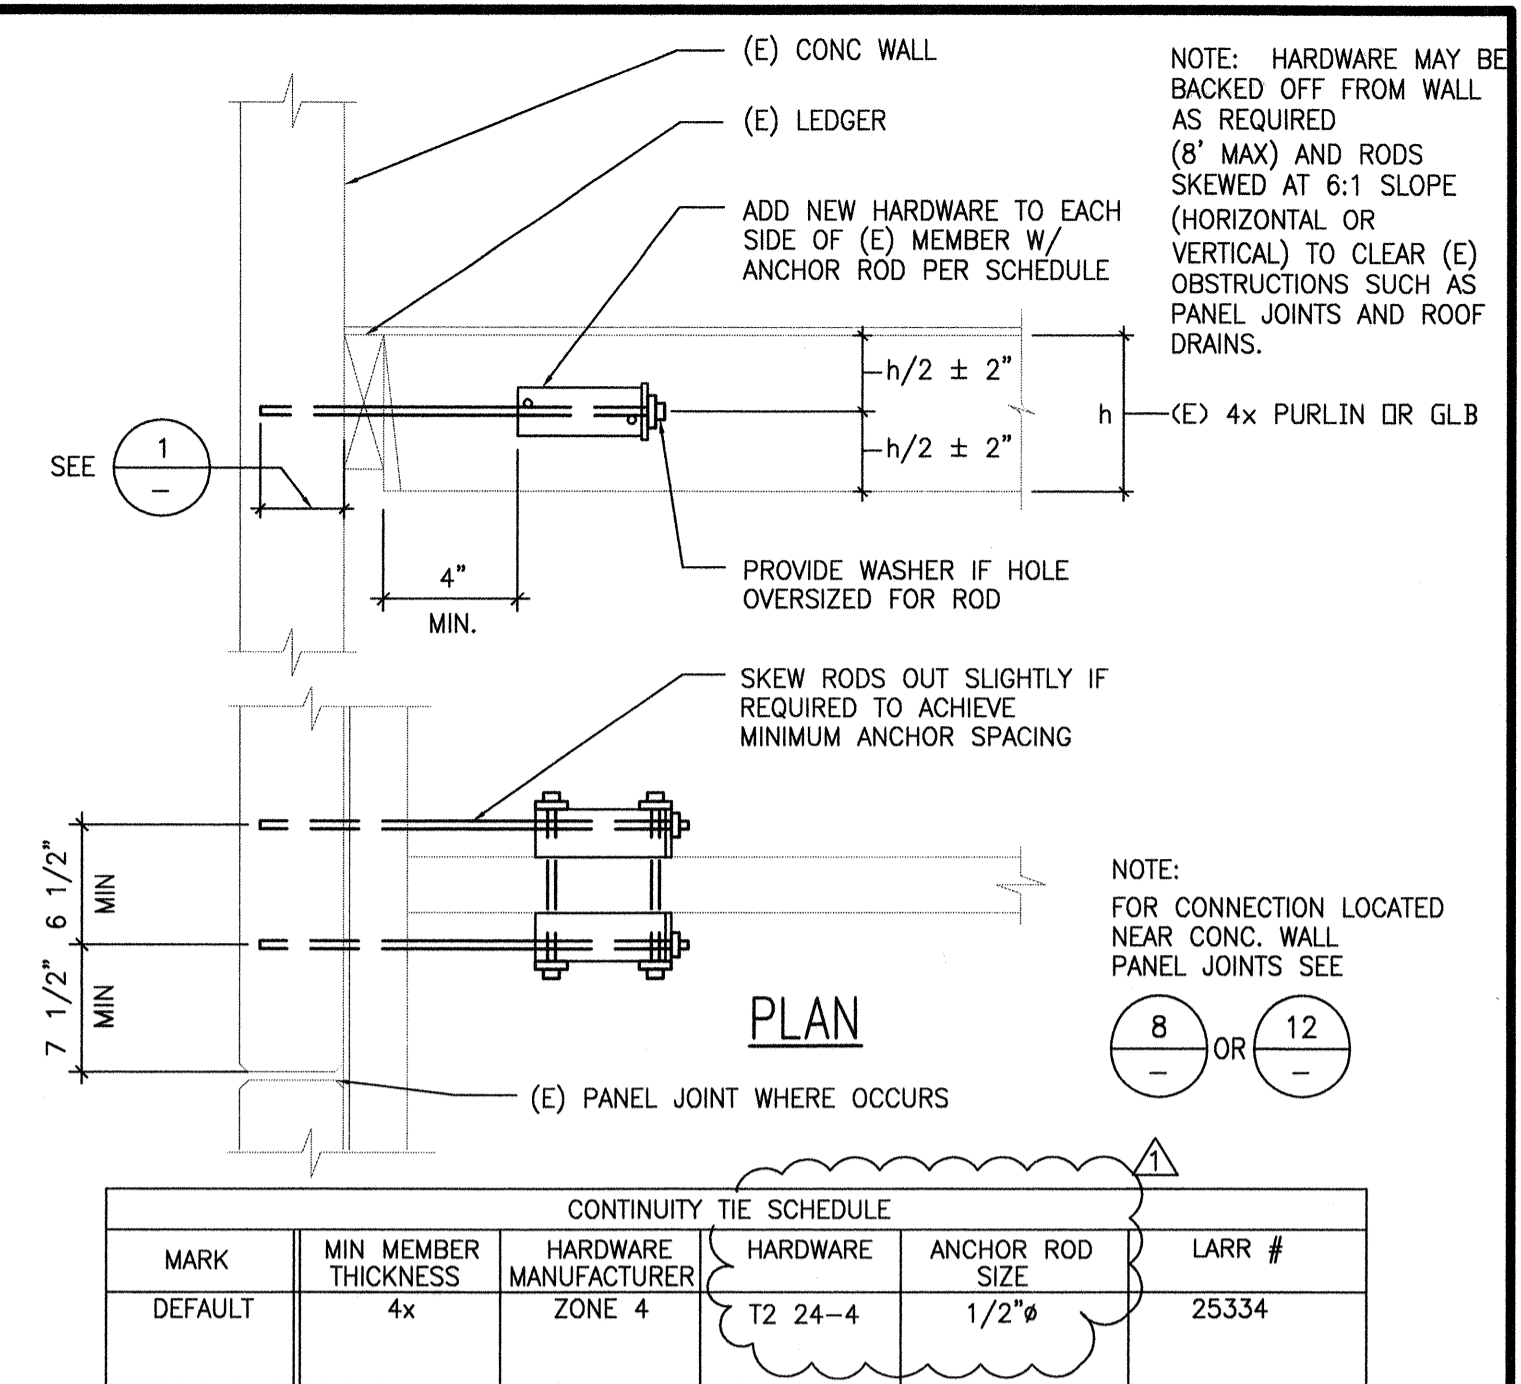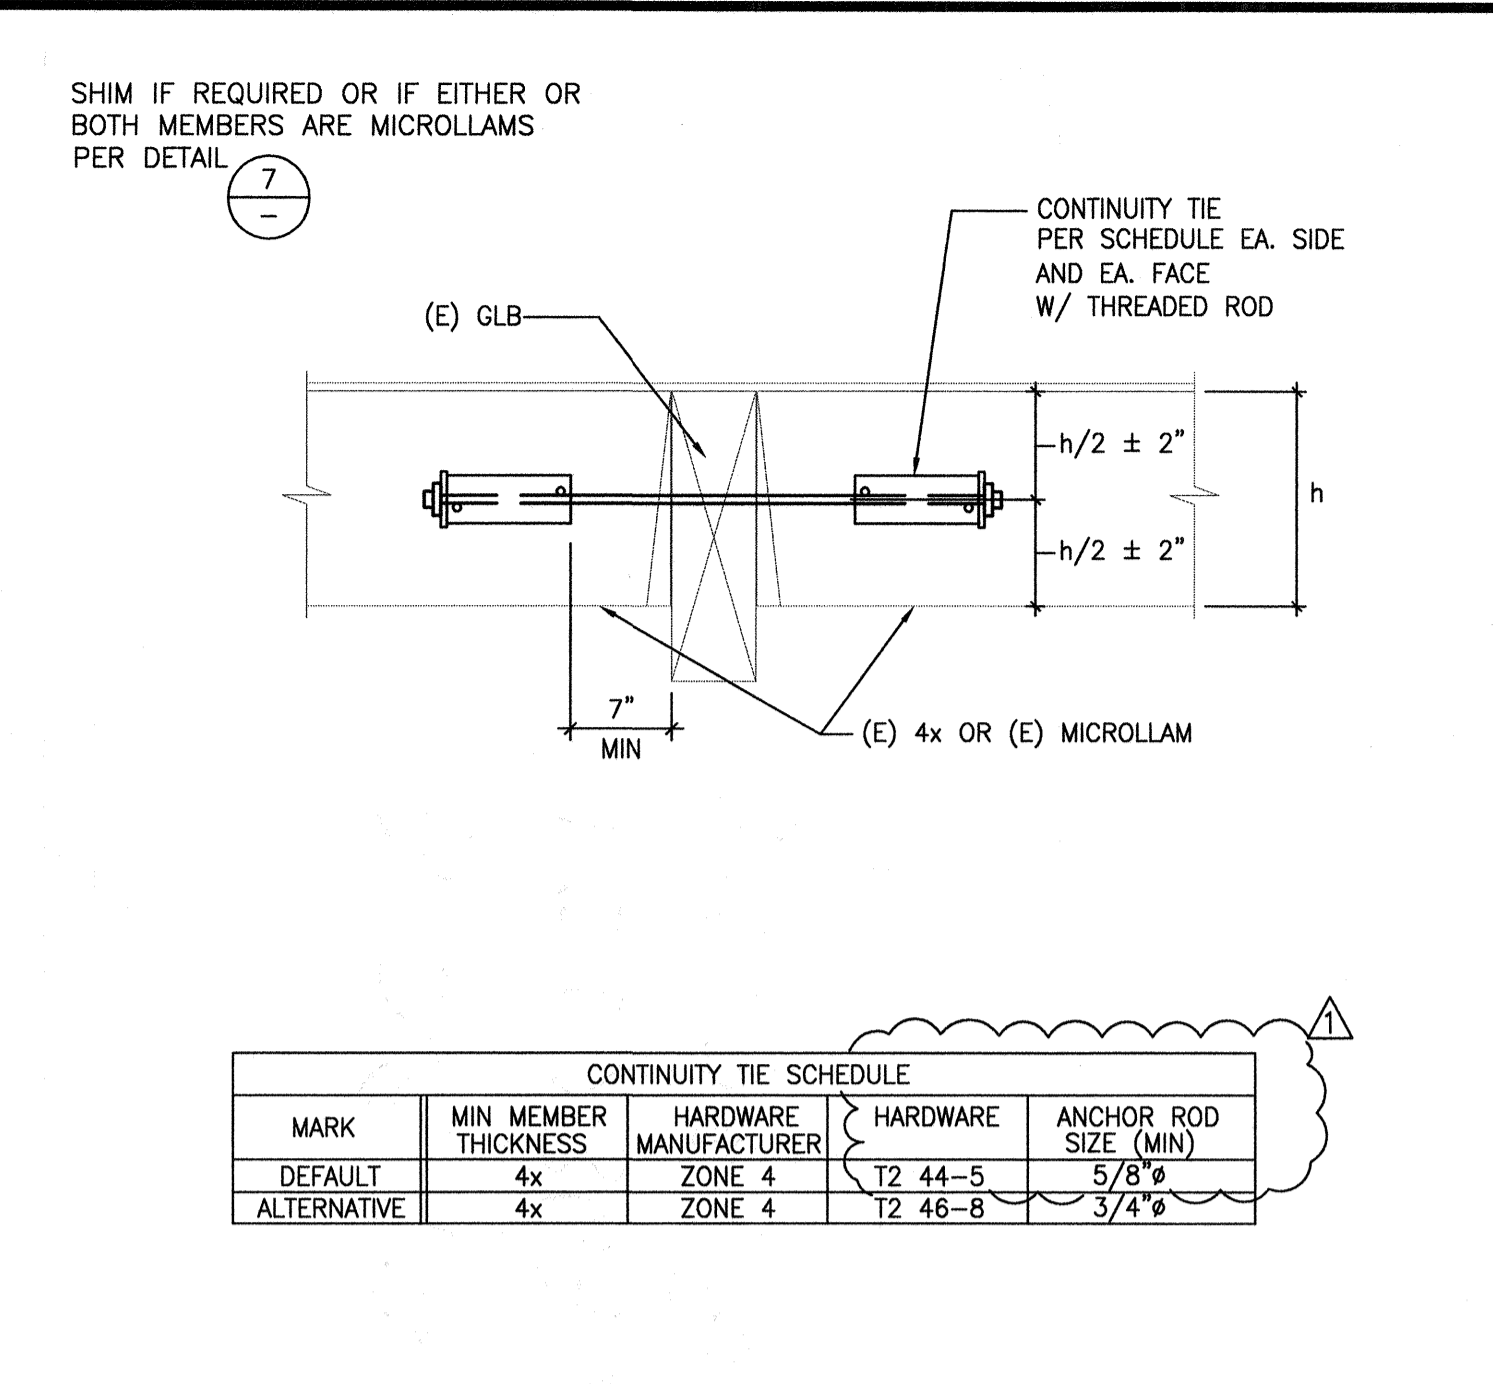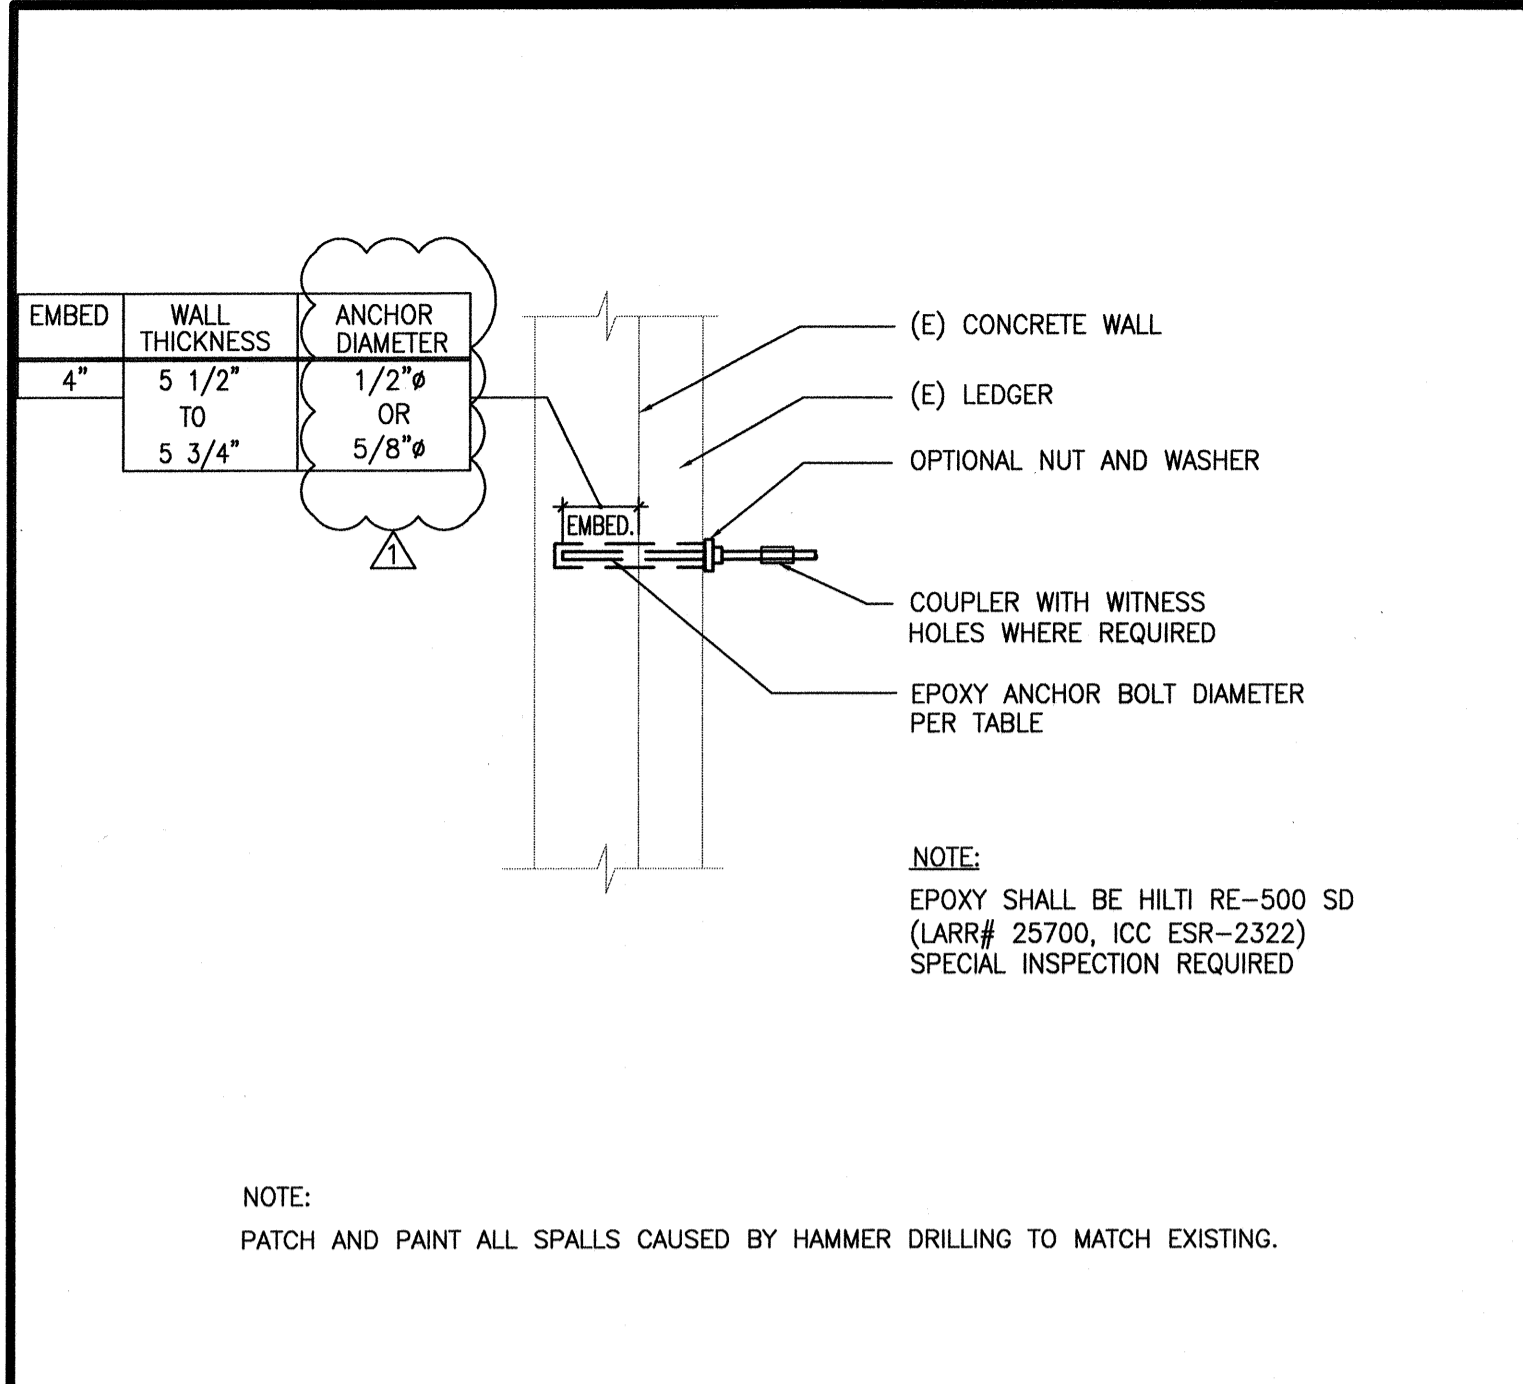

DETAIL SCALE 3/4"=1'-0" 1 CONTINUITY TIE

SCALE 3/4"=1'-0" 2



SCALE N.T.S. 3 WALL ANCHORAGE SCALE 3/4"=1'-0" 4

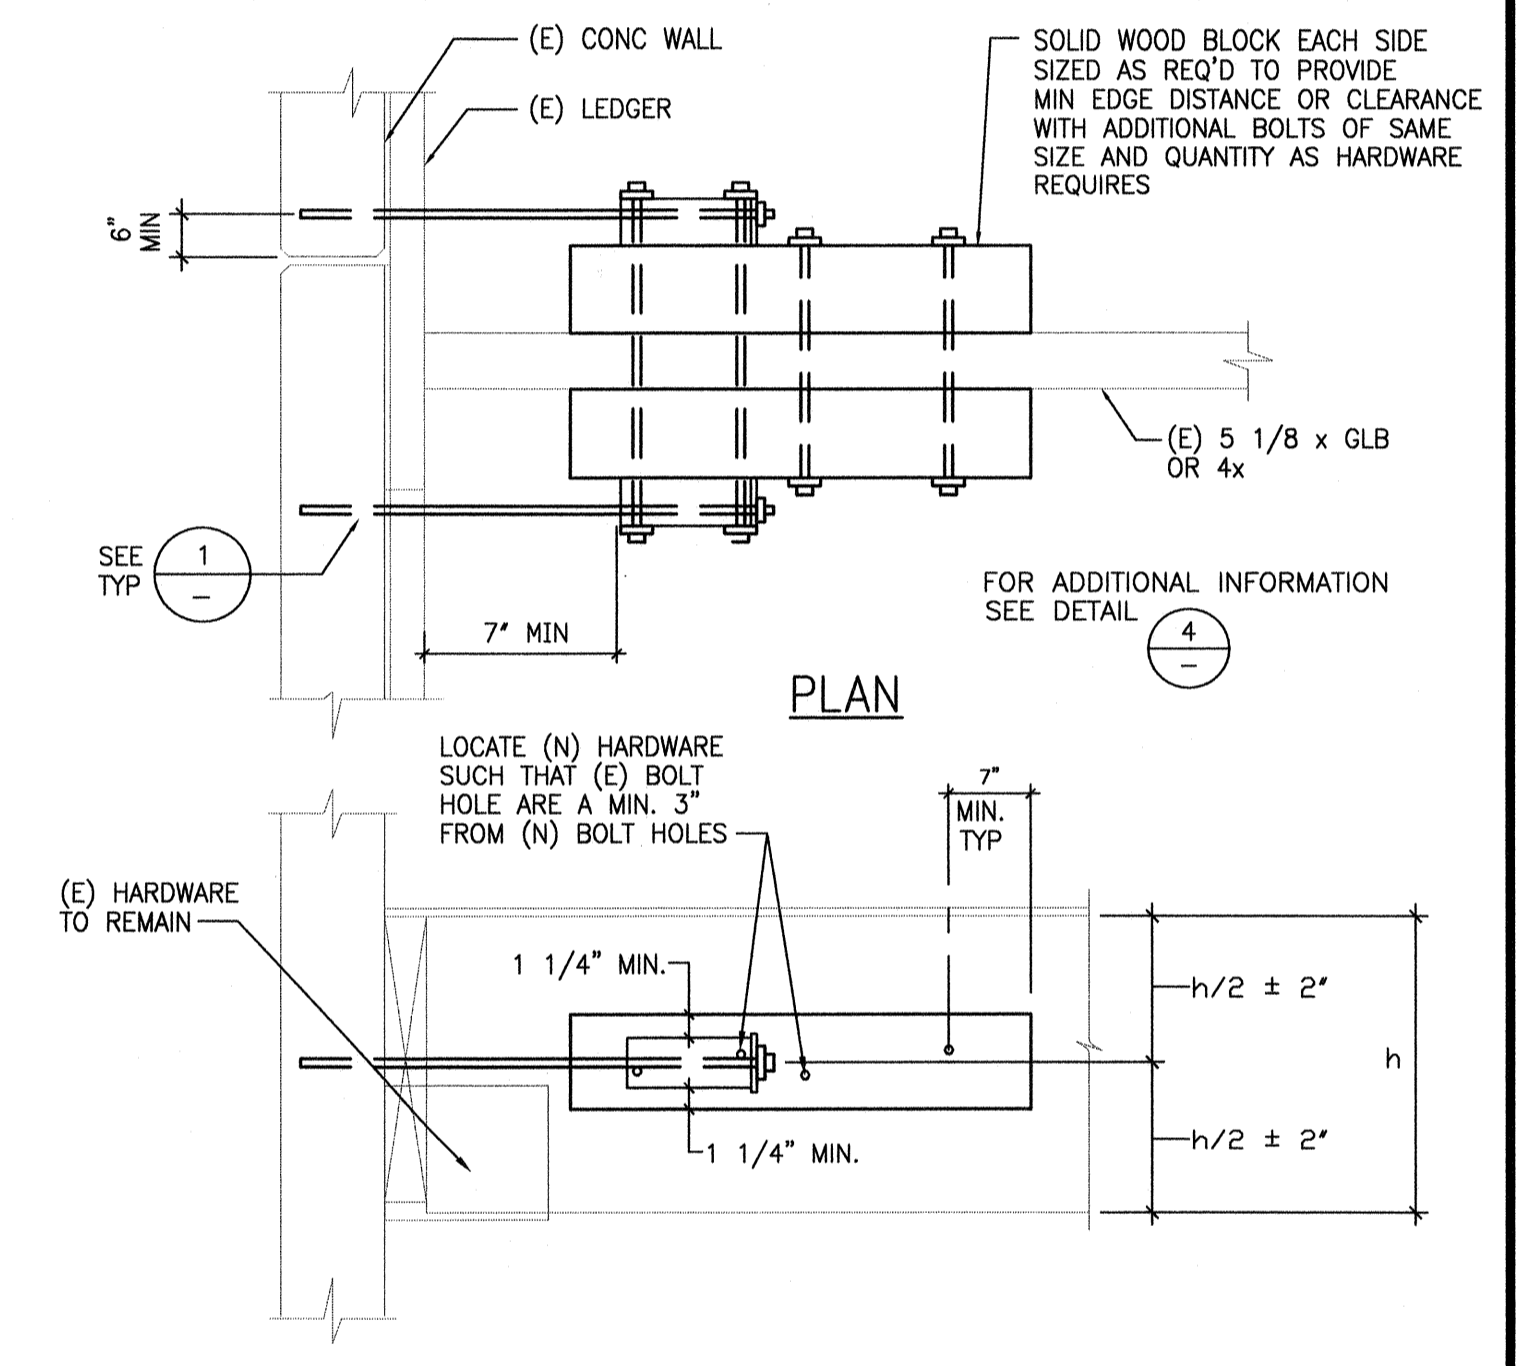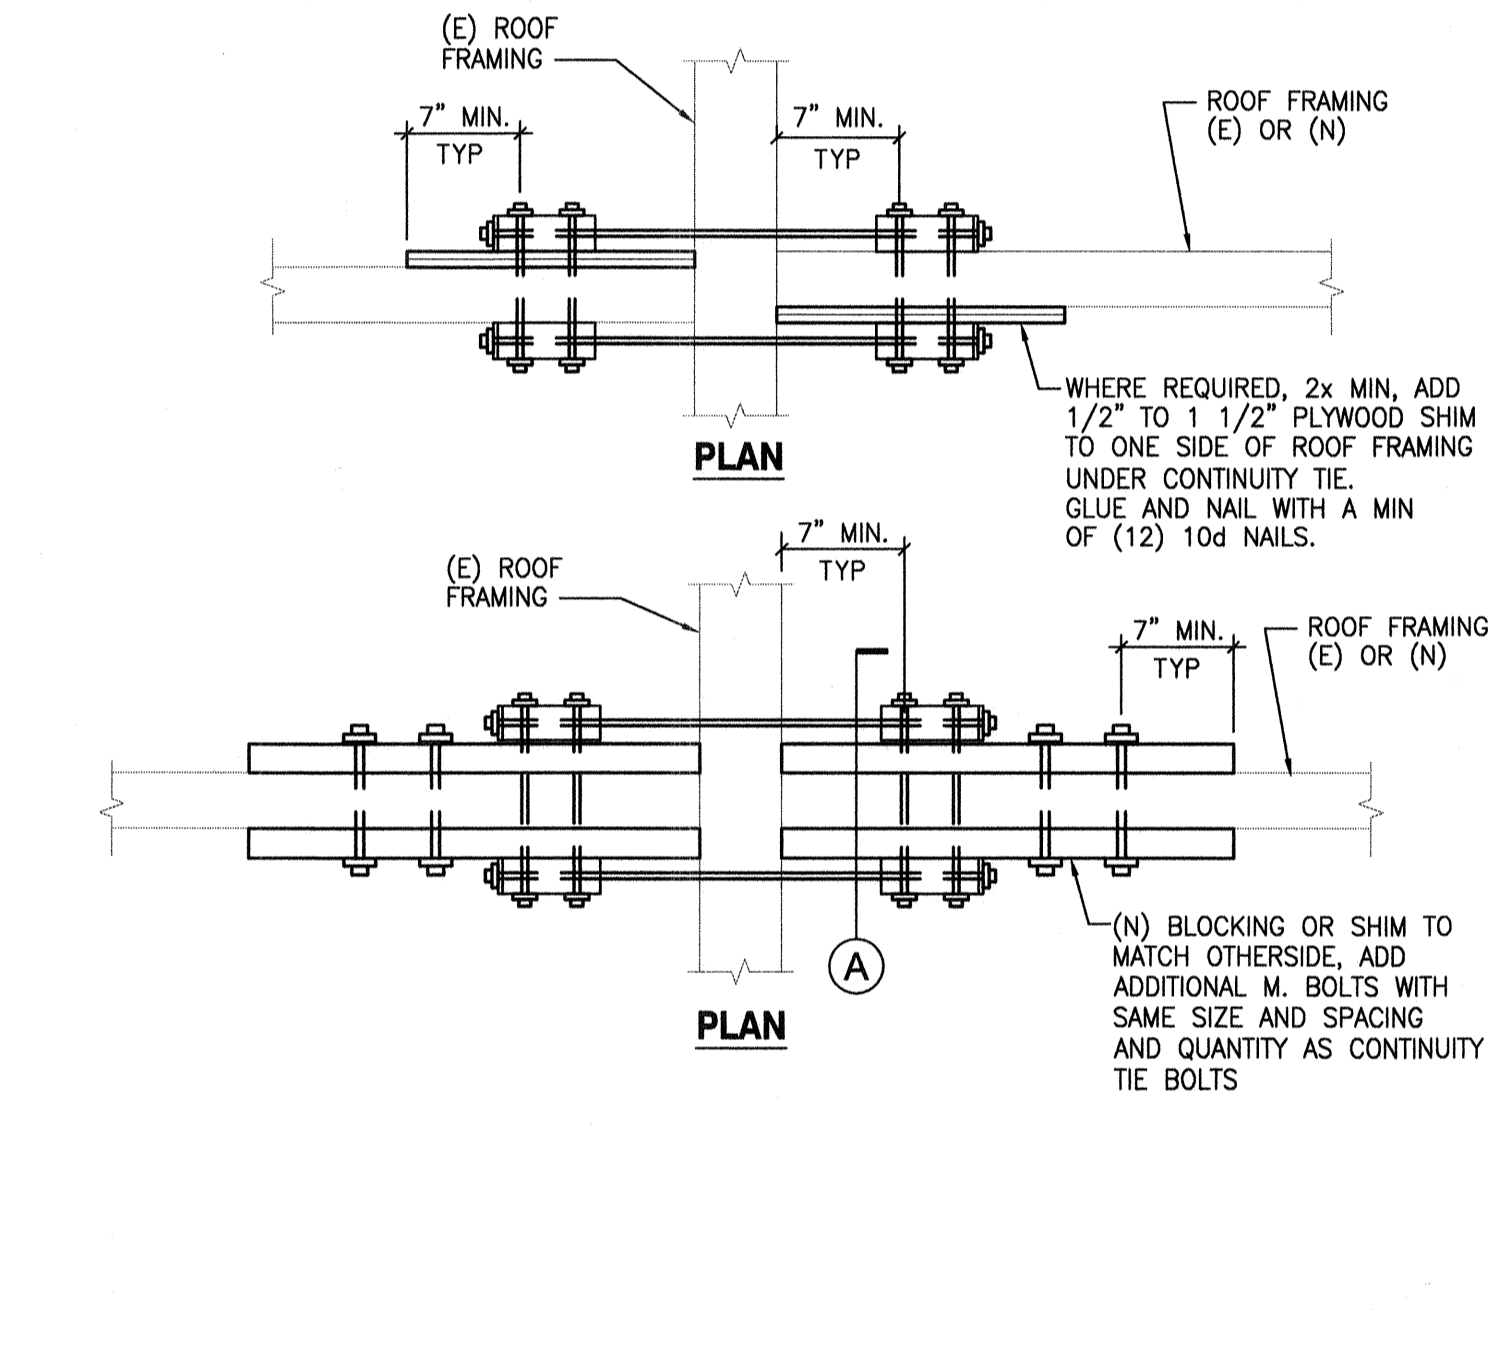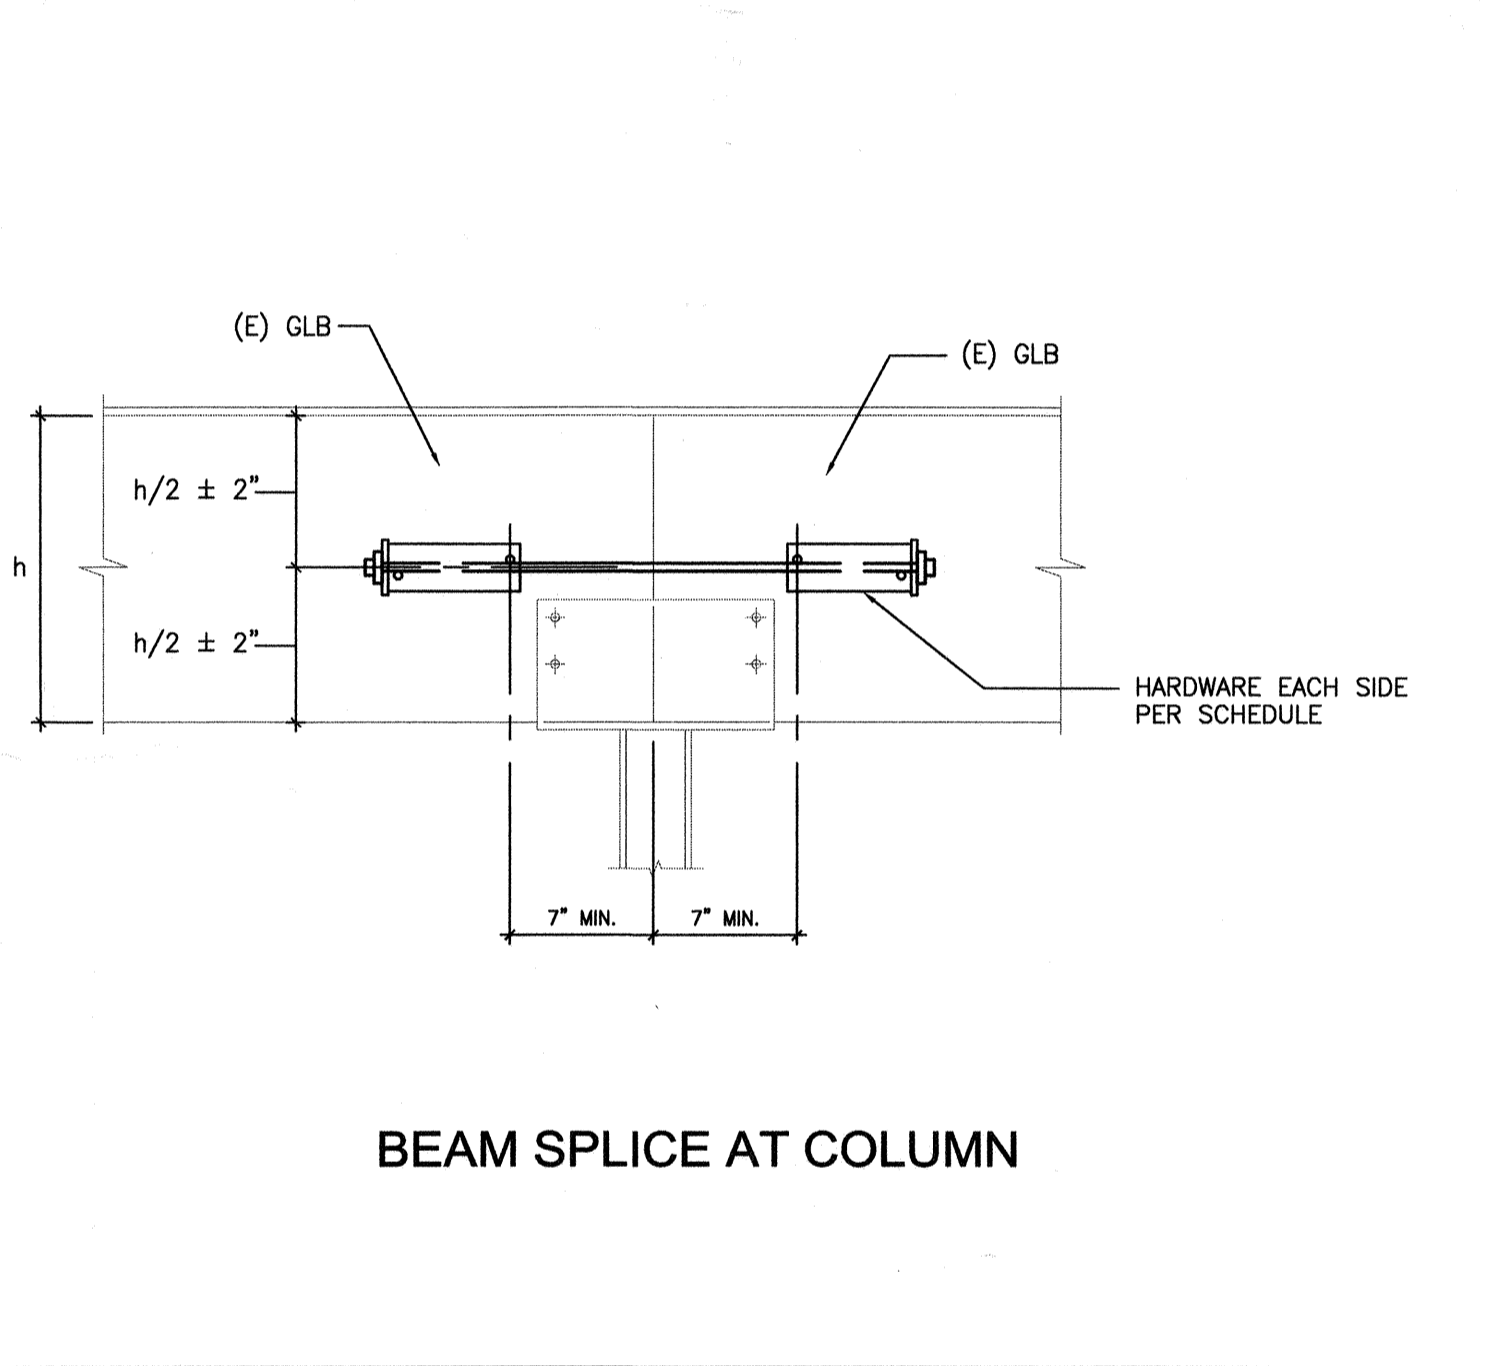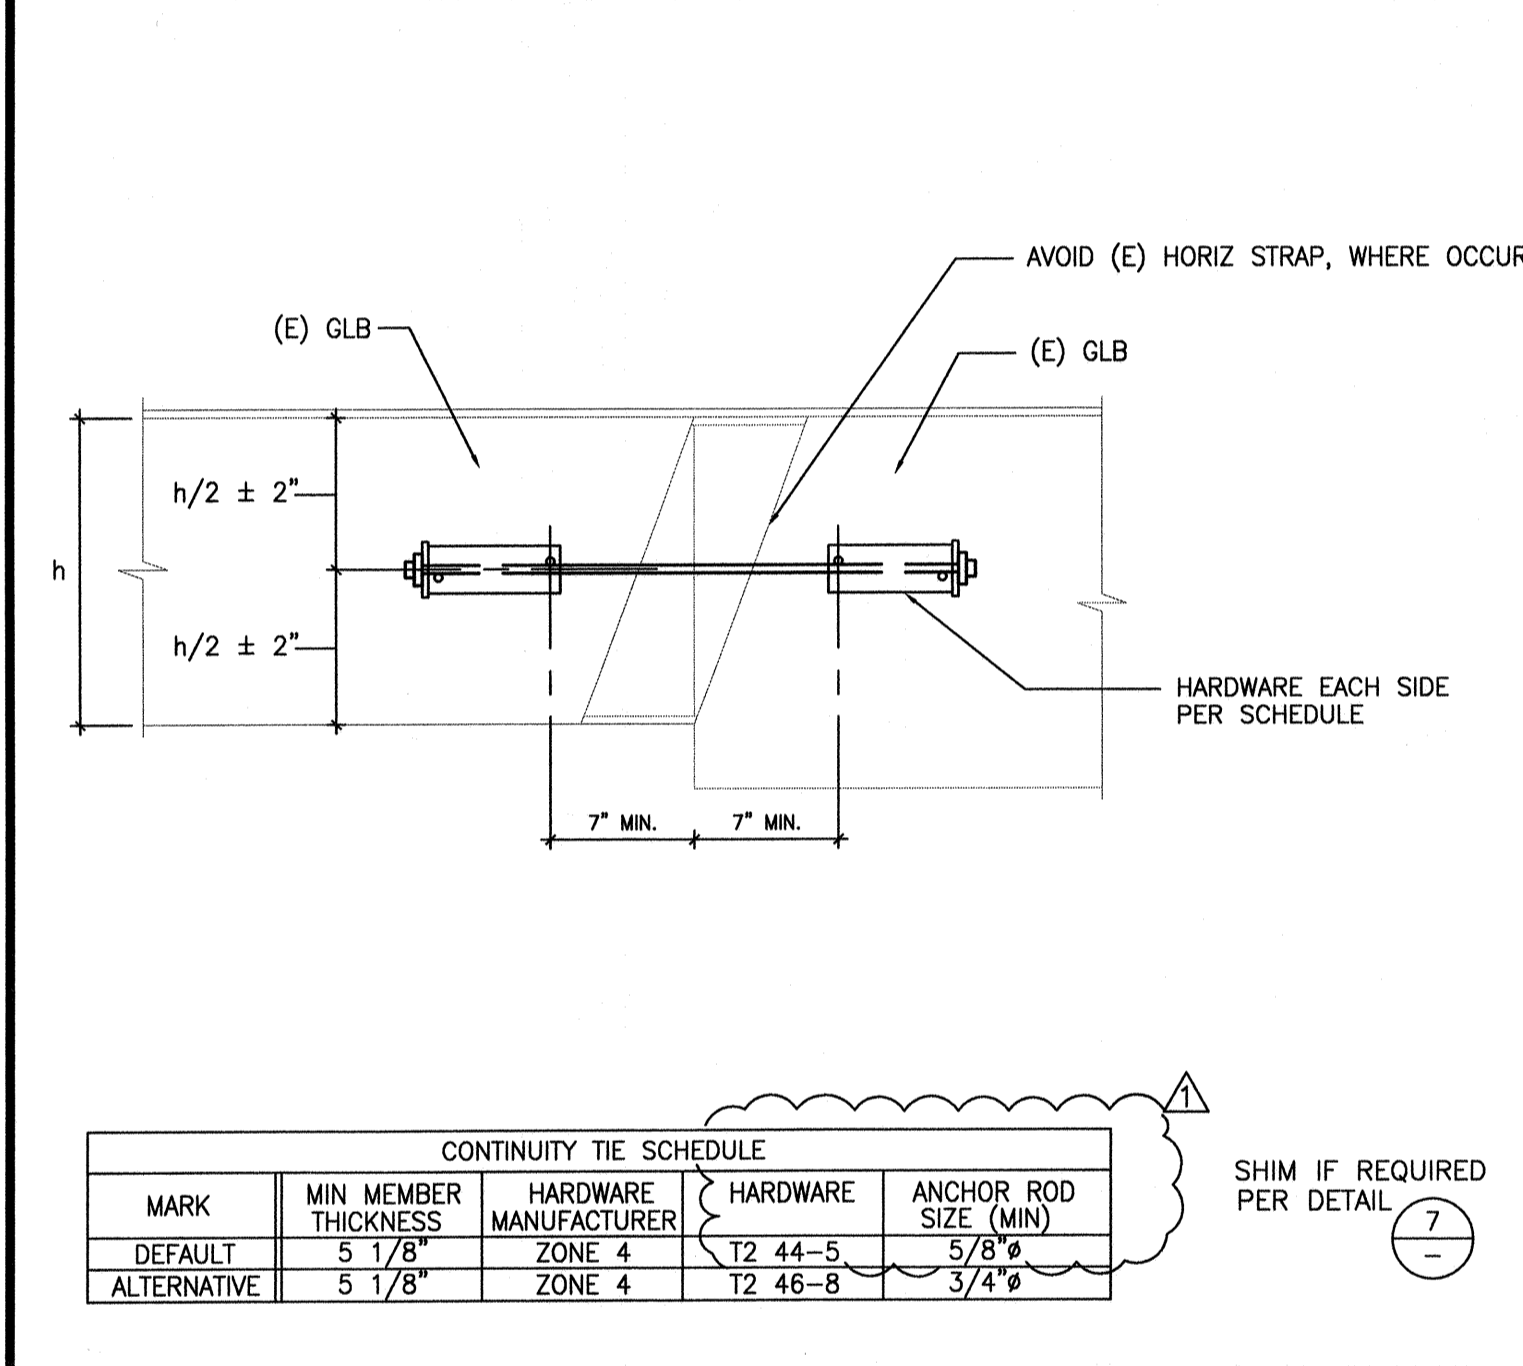

GLB CONTINUITY TIE SCALE 3/4"=1'-0" 6

SCALE 3/4"=1'-0" 7 CONTINUITY TIE SHIM DETAIL

SCALE 3/4"=1'-0" 8 WALL ANCHOR SHIM DETAIL

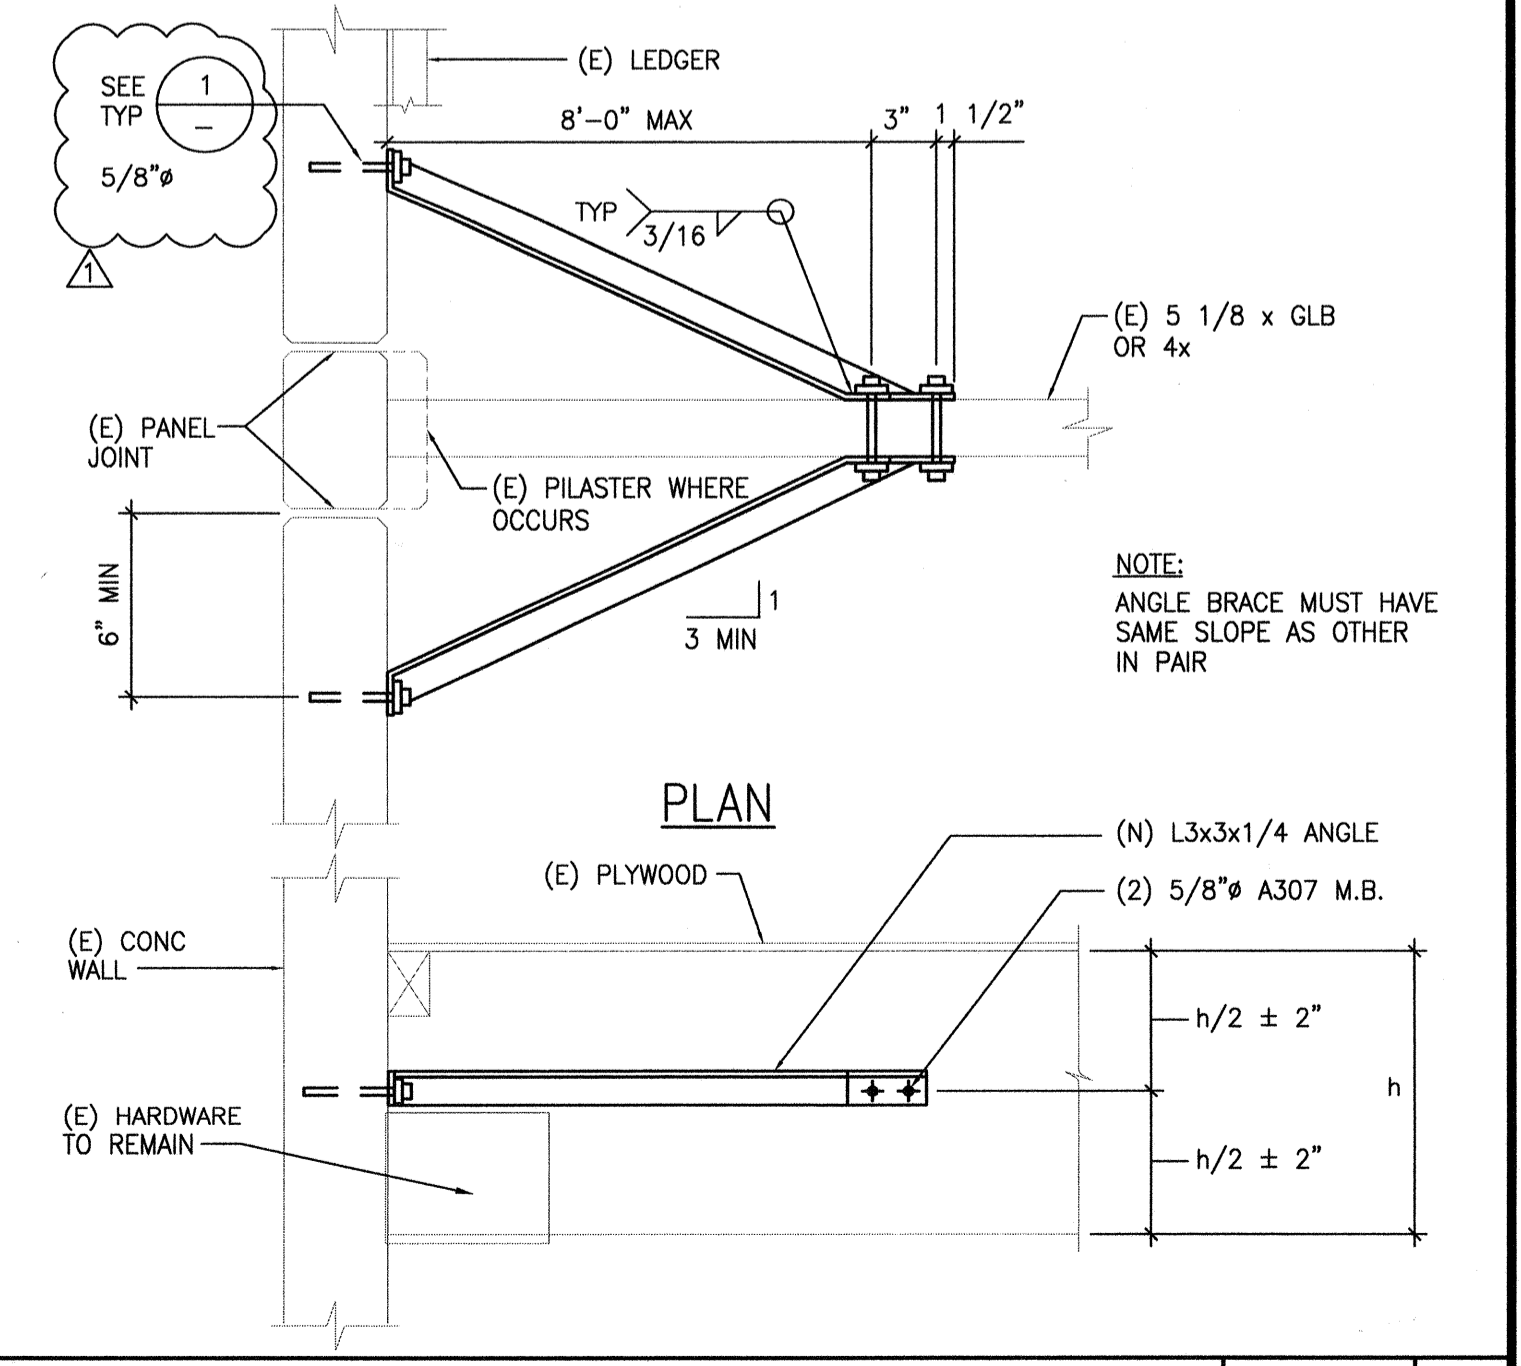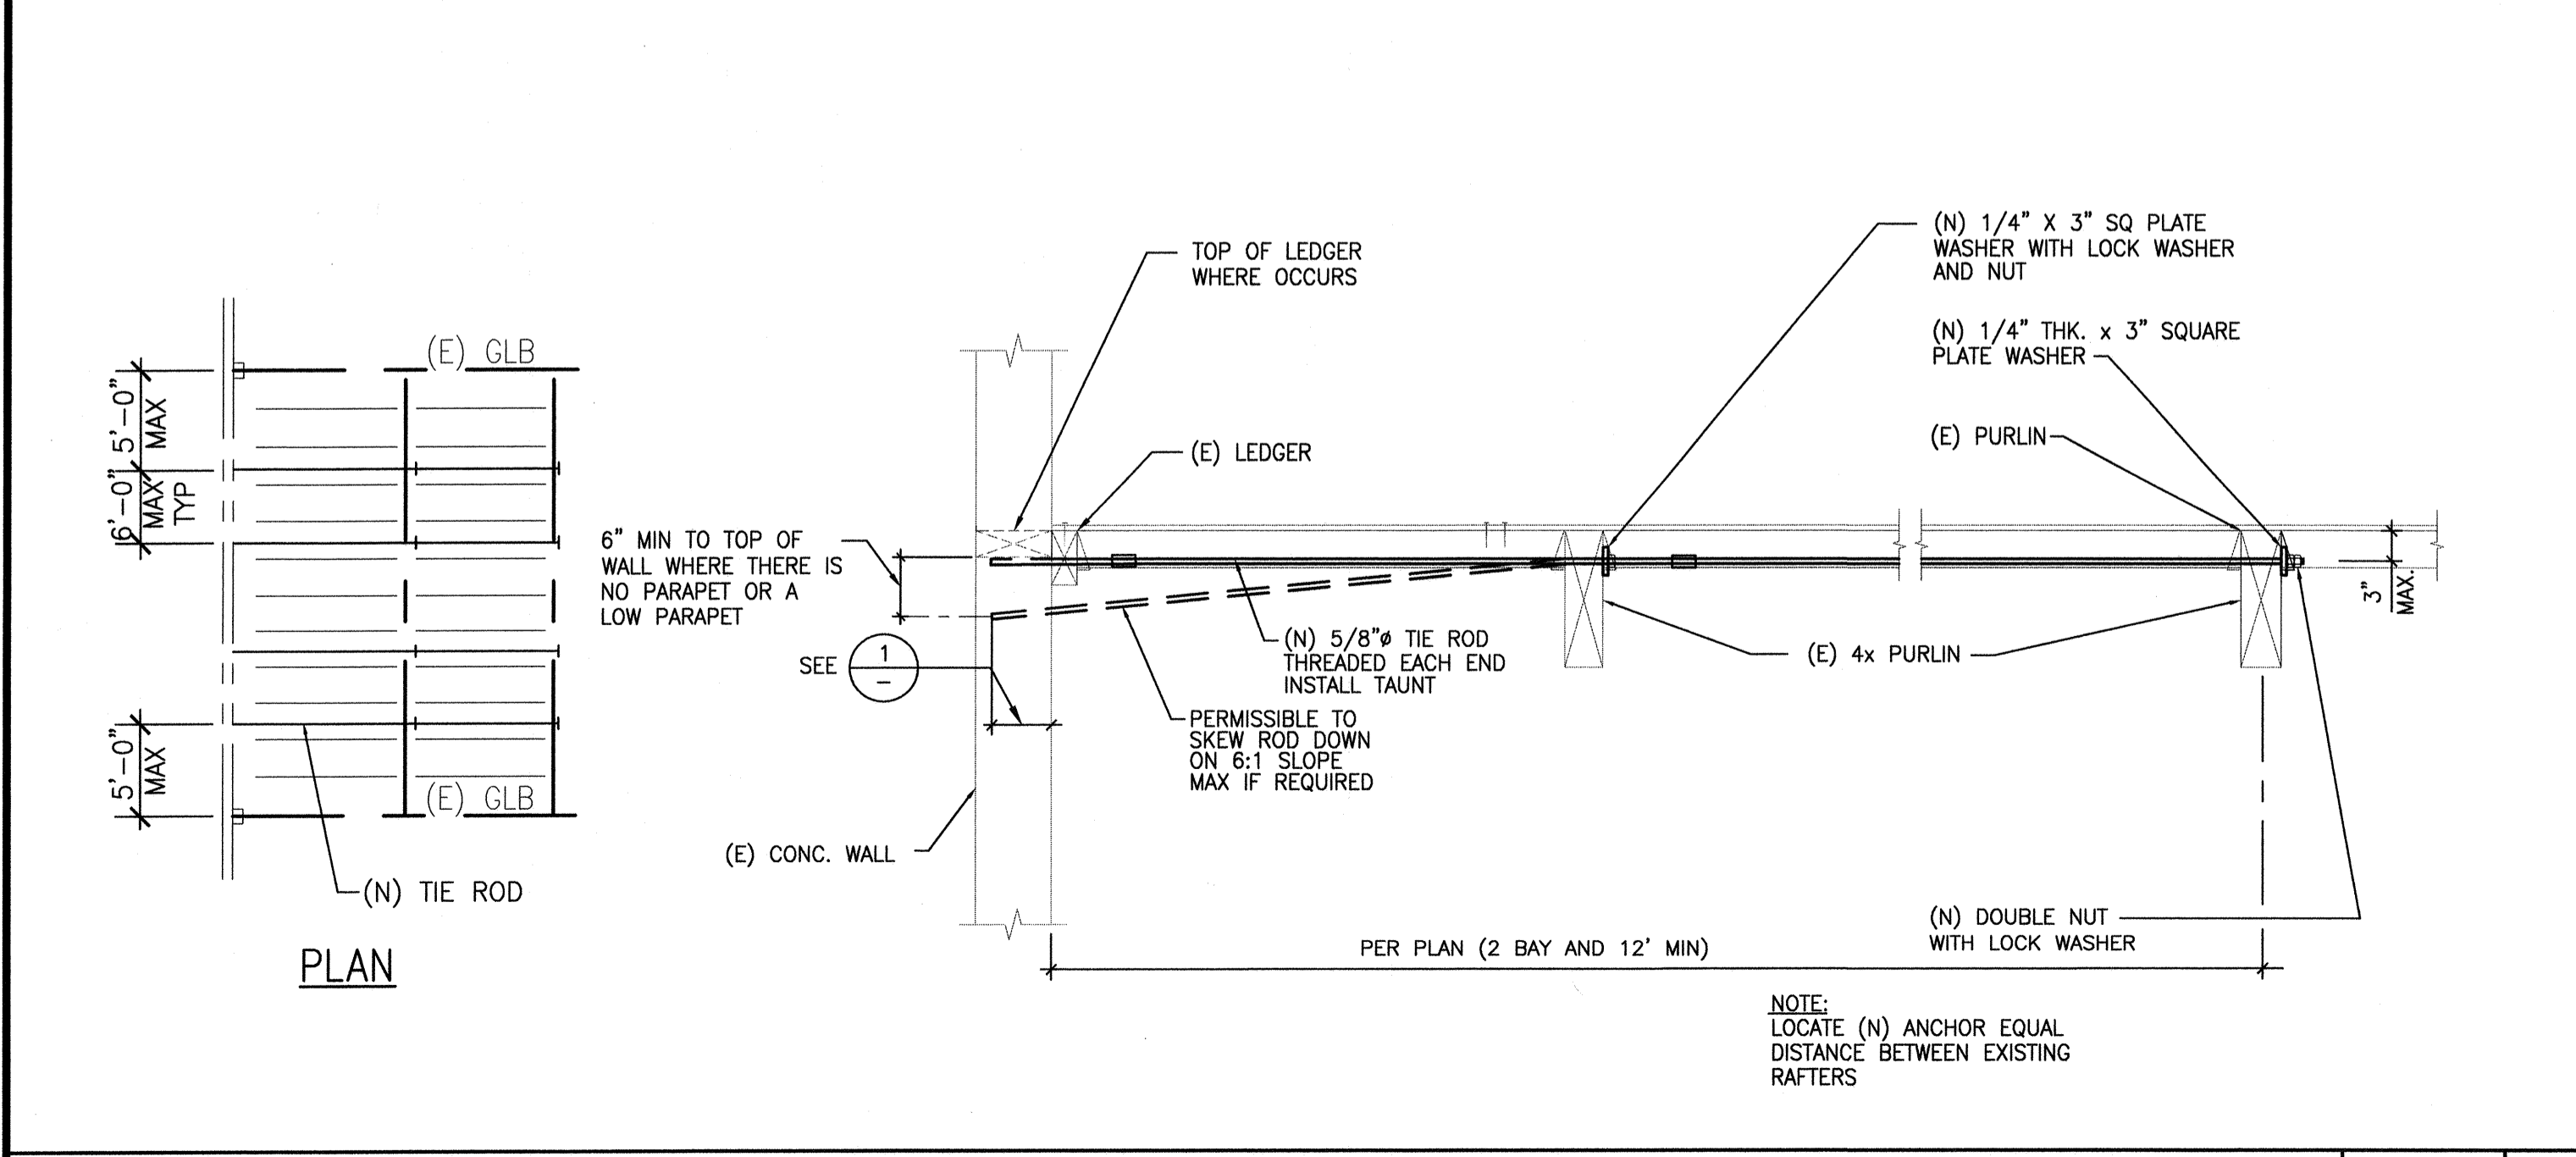

DETAIL SCALE 3/4"=1'-0" 10

NOT USED SCALE 3/4"=1'-0" 11


SCALE 3/4"=1'-0" 12 ALTERNATIVE WALL ANCHOR DETAIL

NATIONAL
ENGINEERING & CONSULTING, INC.
27 ORCHARD LAKE FOREST, CA 95020
PHONE: (949) 715-9970
FAX: (949) 715-9970

Voluntary Seismic Strengthening
AN INDUSTRIAL BLDG. RETROFIT
1917 ST. ANDREW PL. BLDG. F
SANTA ANA CA. 92705

JOB NO. R-Volt-001-F

REVISION:	
10/11/11	CITY SUBMITTAL
12/05/11	RE-SUBMITTAL

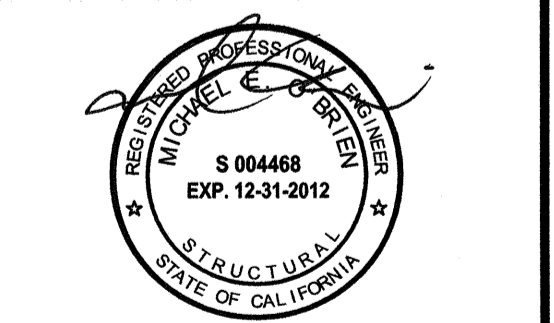

SHEET TITLE:
ROOF FRAMING PLAN

SHEET NUMBER:
SD-1